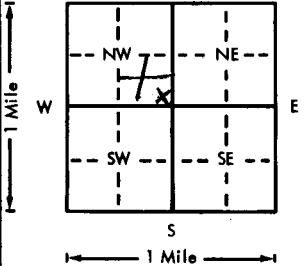


USE TYPEWRITER OR BALL
POINT PEN-PRESS FIRMLY,
PRINT CLEARLY.

WATER WELL RECORD
KSA 82a-1201-1215

Kansas Department of Health and
Environment-Division of Environment
(Water well Contractors)
Topeka, Kansas 66620

1. Location of well:		County <u>Sedgewick</u>	Fraction <u>SE 1/4 SE 1/4 NW 1/4</u>	Section number <u>32</u>	Township number <u>T 27 S</u>	Range number <u>R 1 E @</u>
2. Distance and direction from nearest town or city: Street address of well location if in city: <u>2006 Exchange</u>				3. Owner of well: <u>Robert Shea</u> R.R. or street: <u>2006 Exchange</u> City, state, zip code: <u>Wichita KS 67217</u>		
4. Locate with "X" in section below:		Sketch map:		6. Bore hole dia. <u>9</u> in. Completion date Well depth <u>30</u> ft. <u>9-27-78</u>		
				7. <input type="checkbox"/> Cable tool <input type="checkbox"/> Rotary <input type="checkbox"/> Driven <input type="checkbox"/> Dug <input type="checkbox"/> Hollow rod <input type="checkbox"/> Jetted <input checked="" type="checkbox"/> Bored <input type="checkbox"/> Reverse rotary		
5. Type and color of material				From	To	8. Use: <input type="checkbox"/> Domestic <input type="checkbox"/> Public supply <input type="checkbox"/> Industry <input type="checkbox"/> Irrigation <input type="checkbox"/> Air conditioning <input type="checkbox"/> Stock <input checked="" type="checkbox"/> Low <input type="checkbox"/> Oil field water <input type="checkbox"/> Other
<u>Drk Brn Sandy Clay loam</u>				<u>0</u>	<u>1</u>	9. Casing: Material <u>RMP</u> Height: Above or below Threaded <input type="checkbox"/> Welded <input checked="" type="checkbox"/> Surface <u>12</u> in. RMP <input checked="" type="checkbox"/> PVC <input type="checkbox"/> Weight <u> </u> lbs./ft. Dia. <u>4</u> in. to <u>0</u> ft. depth Wall Thickness: inches or Dia. <u>4</u> in. to <u>30</u> ft. depth Gage No. <u>120</u>
<u>LT. Tan med. fine Sand</u>				<u>1</u>	<u>15</u>	10. Screen: Manufacturer's name <u>Sunflower Mfg. Co</u> Type <u>RMP</u> Dia. <u> </u> Slot/gauze <u>3/16</u> Length <u>5 FT</u> Set between <u>25</u> ft. and <u>30</u> ft. ft. and <u> </u> ft. Gravel pack? <u>No</u> Size range of material <u> </u>
<u>LT. Brn med Course gravel</u>				<u>15</u>	<u>30</u>	11. Static water level: <u> </u> mo./day/yr. <u>12</u> ft. below land surface Date <u>9-27-78</u>
						12. Pumping level below land surfaces: <u>16</u> ft. after <u>1</u> hrs. pumping <u>10</u> g.p.m. <u> </u> ft. after <u> </u> hrs. pumping <u> </u> g.p.m. Estimated maximum yield <u>50</u> g.p.m.
						13. Water sample submitted: <u> </u> mo./day/yr. Yes <input checked="" type="checkbox"/> No <input type="checkbox"/> Date <u> </u>
						14. Well head completion: <u> </u> Pitless adapter <u>12</u> inches above grade
						15. Well grouted? <u>yes</u> With: <u> </u> Neat cement <u> </u> Bentonite <input checked="" type="checkbox"/> Concrete Depth: From <u>0</u> ft. to <u>10</u> ft.
						16. Nearest source of possible contamination: ft. <u>10</u> Direction <u>SW</u> Type <u>Sewer</u> Well disinfected upon completion? <u> </u> Yes <input checked="" type="checkbox"/> No <input type="checkbox"/>
						17. Pump: <u> </u> Not installed Manufacturer's name <u>FESW</u> Model number <u>5CP055</u> HP <u>1/2</u> Volts <u>115</u> Length of drop pipe <u>25</u> ft. capacity <u>10</u> g.p.m. Type: <input checked="" type="checkbox"/> Submersible <input type="checkbox"/> Turbine <input checked="" type="checkbox"/> Jet <input type="checkbox"/> Reciprocating <input type="checkbox"/> Centrifugal <input type="checkbox"/> Other
(Use a second sheet if needed)						
18. Elevation:		19. Remarks:		20. Water well contractor's certification: This well was drilled under my jurisdiction and this report is true to the best of my knowledge and belief. <u>Butterhoe Pump & Well 295</u> Business name <u>Butterhoe Pump & Well</u> License No. <u> </u> Address <u>221 W 27th St Wichita KS</u> Signed <u> </u> Date <u>9-27-78</u> Authorized representative		
Topography: <input type="checkbox"/> Hill <input type="checkbox"/> Slope <input type="checkbox"/> Upland <input checked="" type="checkbox"/> Valley						

Forward the white, blue and pink copies to the Department of Health and Environment

Form WWC-5