



# DENNIS L HANDKE

1820 NW 59th Terrace  
TOPEKA, KANSAS 66618  
785-286-4047 Home  
785-217-5864 Cell

Meredith Watson  
TerraNext, LLC  
11904 Grandview Ave.  
Grandview, Missouri, 64030

November 3, 2017

RE: Monitor Well Elevation Survey  
6330 E. 21<sup>th</sup> Street, Wichita, Kansas

Proj. 17-00GG  
Kum & Go #328

Bench Mark: Chisled X on the top NW bolt of NW concrete signal light base near SE corner of property.  
Elev: 1389.49      North 45.10      West 55.41      (from SE Cor. Sec.1-27-1E)

MW-1R	rim	1390.43	North	61.23	West	109.41	SE1/4,SE1/4,SE1/4,SE1/4
	top pipe	1390.18					Lat= 37.72318    Long = 97.26267
MW-2R	rim	1389.87	North	95.51	West	85.90	SE1/4,SE1/4,SE1/4,SE1/4
	top pipe	1389.63					Lat= 37.72328    Long = 97.26259
MW-3R	rim	1390.55	North	60.79	West	175.27	SE1/4,SE1/4,SE1/4,SE1/4
	top pipe	1390.31					Lat= 37.72318    Long = 97.26290
MW-4R	rim	1391.13	North	131.69	West	179.37	SE1/4,SE1/4,SE1/4,SE1/4
	top pipe	1390.85					Lat= 37.72338    Long = 97.26292
MW-5R	rim	1389.92	North	56.29	West	66.79	SE1/4,SE1/4,SE1/4,SE1/4
	top pipe	1389.65					Lat= 37.72317    Long = 97.26253
MW-8R	rim	1387.84	North	152.66	East	79.36	SW1/4,SW1/4,SW1/4,SW1/4 (Sec. 6-27-2)
	top pipe	1387.48					Lat= 37.72344    Long = 97.26202


Elevation derived from City of Wichita Bench Mark.NAVD88

Lat & Long derived from Wichita East 7.5 minute Quad Map WGS84.

If you have any questions, please feel free to call me. Thank you for the opportunity to be of service to you.

November 3, 2017  
Dennis L. Handke RS

*Dennis L. Handke*

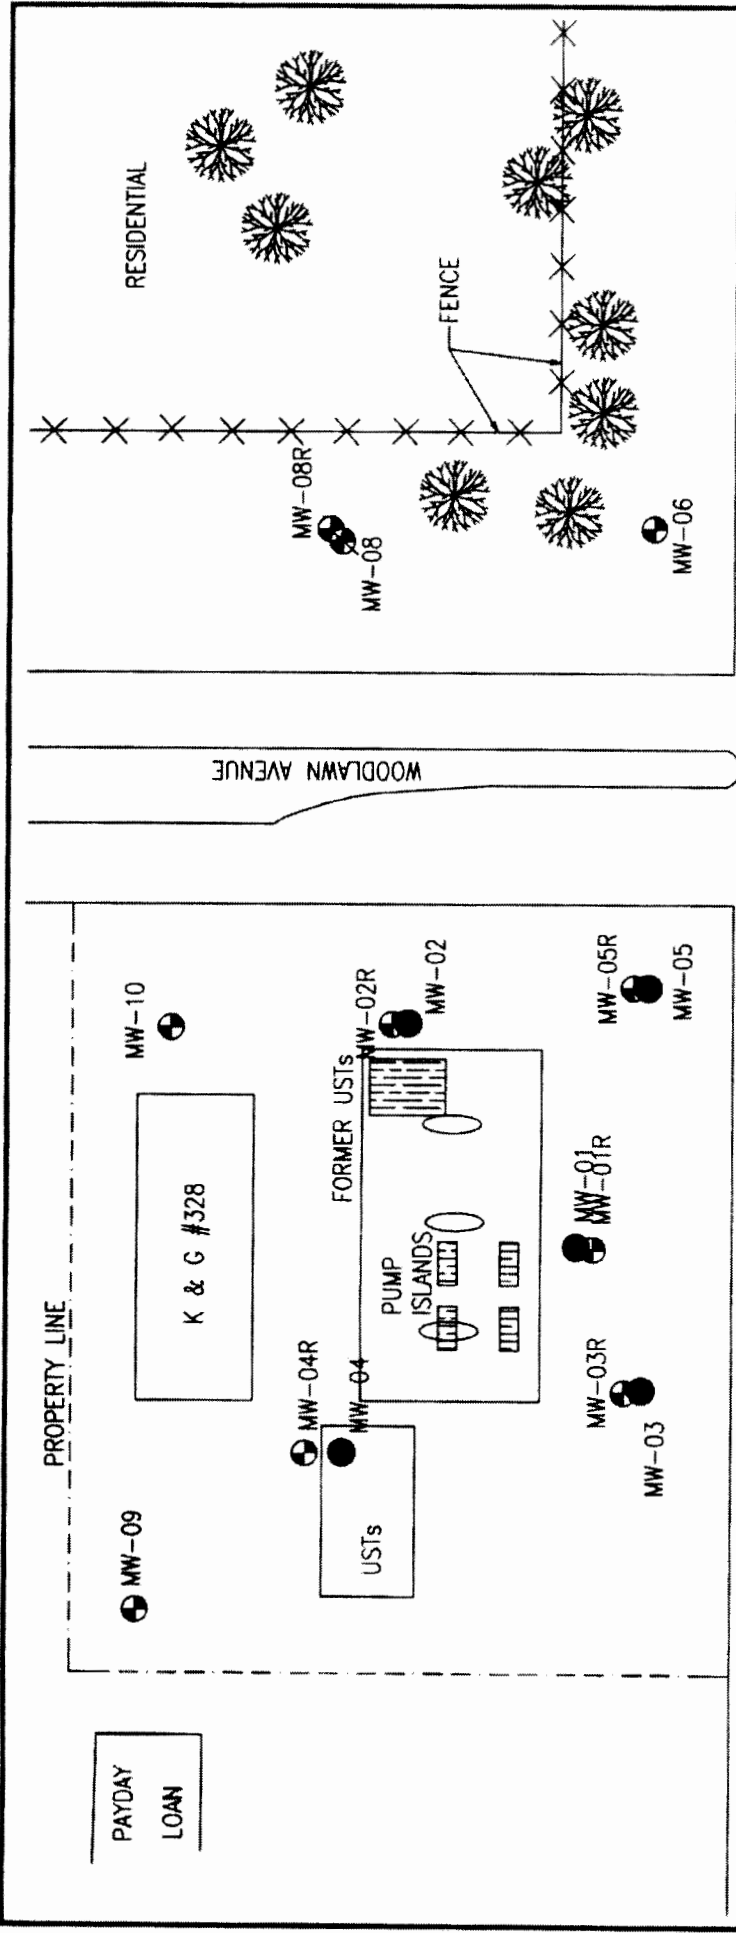

**LEGEND**

- MONITORING WELL
- ⊗ DESTROYED MONITORING WELL
- - - PROPERTY LINE

415 TOTAL BTEX CONC. IN ug/l

-100- TOTAL BTEX ISOCONC. LINE

ND NOT DETECTED

NS NOT SAMPLED

BENCHMARK LOCATION UNKNOWN

21ST STREET

MIDWAY OIL

EMPRISE BANK

MW-07

APPROXIMATE SCALE (FEET)

0 25 50 100

PROJ.# 17102233	PAGE#	SCALE: AS SHOWN	DRAWN BY:
FILE NO. 2233-F2	DESIGNED BY:	APPROVED BY:	
DATE:			

**FIGURE 1**  
**SITE MAP**  
 OCTOBER 17, 2017  
 KUM & GO #328  
 6330 EAST 21ST STREET  
 WICHITA, KANSAS