
WATER WELL RECORD Form WWC-5 KSA 82a-1212 1 LOCATION OF WATER WELL: FRACTION SECTION NUMBER TOWNSHIP NUMBER RANGE NUMBER SWSedgwick SE NE 11 Т 27 1/4 1/4 1/4 S R 1E E/W Distance and direction from nearest town or city street address of well if located within city? 13902 E. Steeple Chase Circle Wichita, Kansas **FAHSHOLTZ CONSTRUCTION** WATER WELL OWNER: Board of Agriculture, Division of Water Resource RR#,ST. ADDRESS,BOX #: P.O.Box 818 ZIP CODE: 67002 Wichita, Kansas CITY, STATE: Application Number 95 4 DEPTH OF COMPLETED WELL: ELEVATION: LOCATE WELL'S LOCATION WITH AN "X" IN SECTION BOX: Depth of groundwater Encountered: ft. ft. ft. Ν 38 WELL'S STATIC WATER LEVEL FT. BELOW LAND SURFACE MEASURED ON mo/day/yr: 11/30/17 Pump test data: Well water was ft. after hours of pumping @ NW NEapm Est. Yield: ft. after gpm Well water was hours of pumping @ gpm 12 95 Bore Hole Diameter and ft.

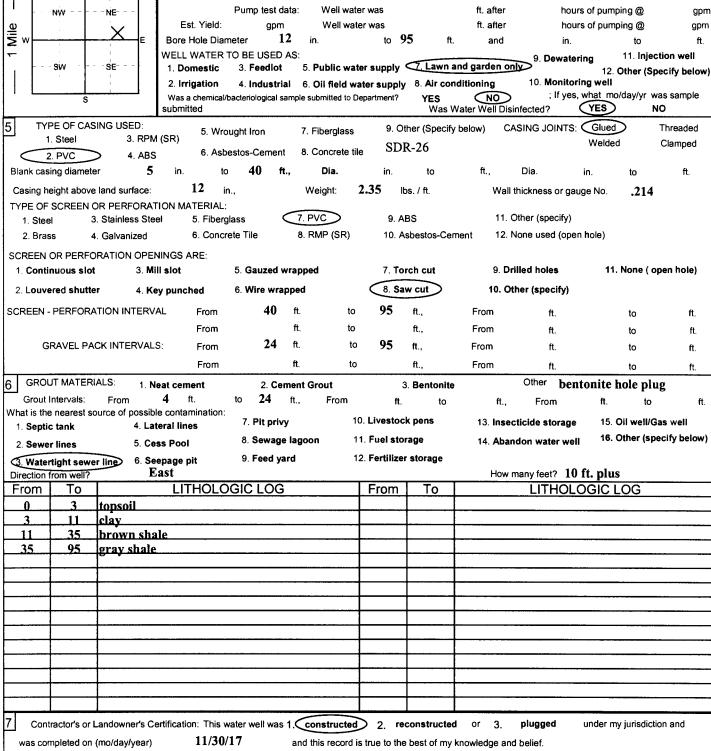

This water well record was completed on (mo/day/year)

by (signature)

12/1/17

Todd S. Harp

Kansas Water Well Contractor's License No. 236

under the business name of Harp Well and Pump Service