


WATER WELL RECORD Form WWC-5

☐ Original Record ☐ Correction ☐ Change in Well Use

Division of Water
Resources App. No.

Well ID

[illegible]

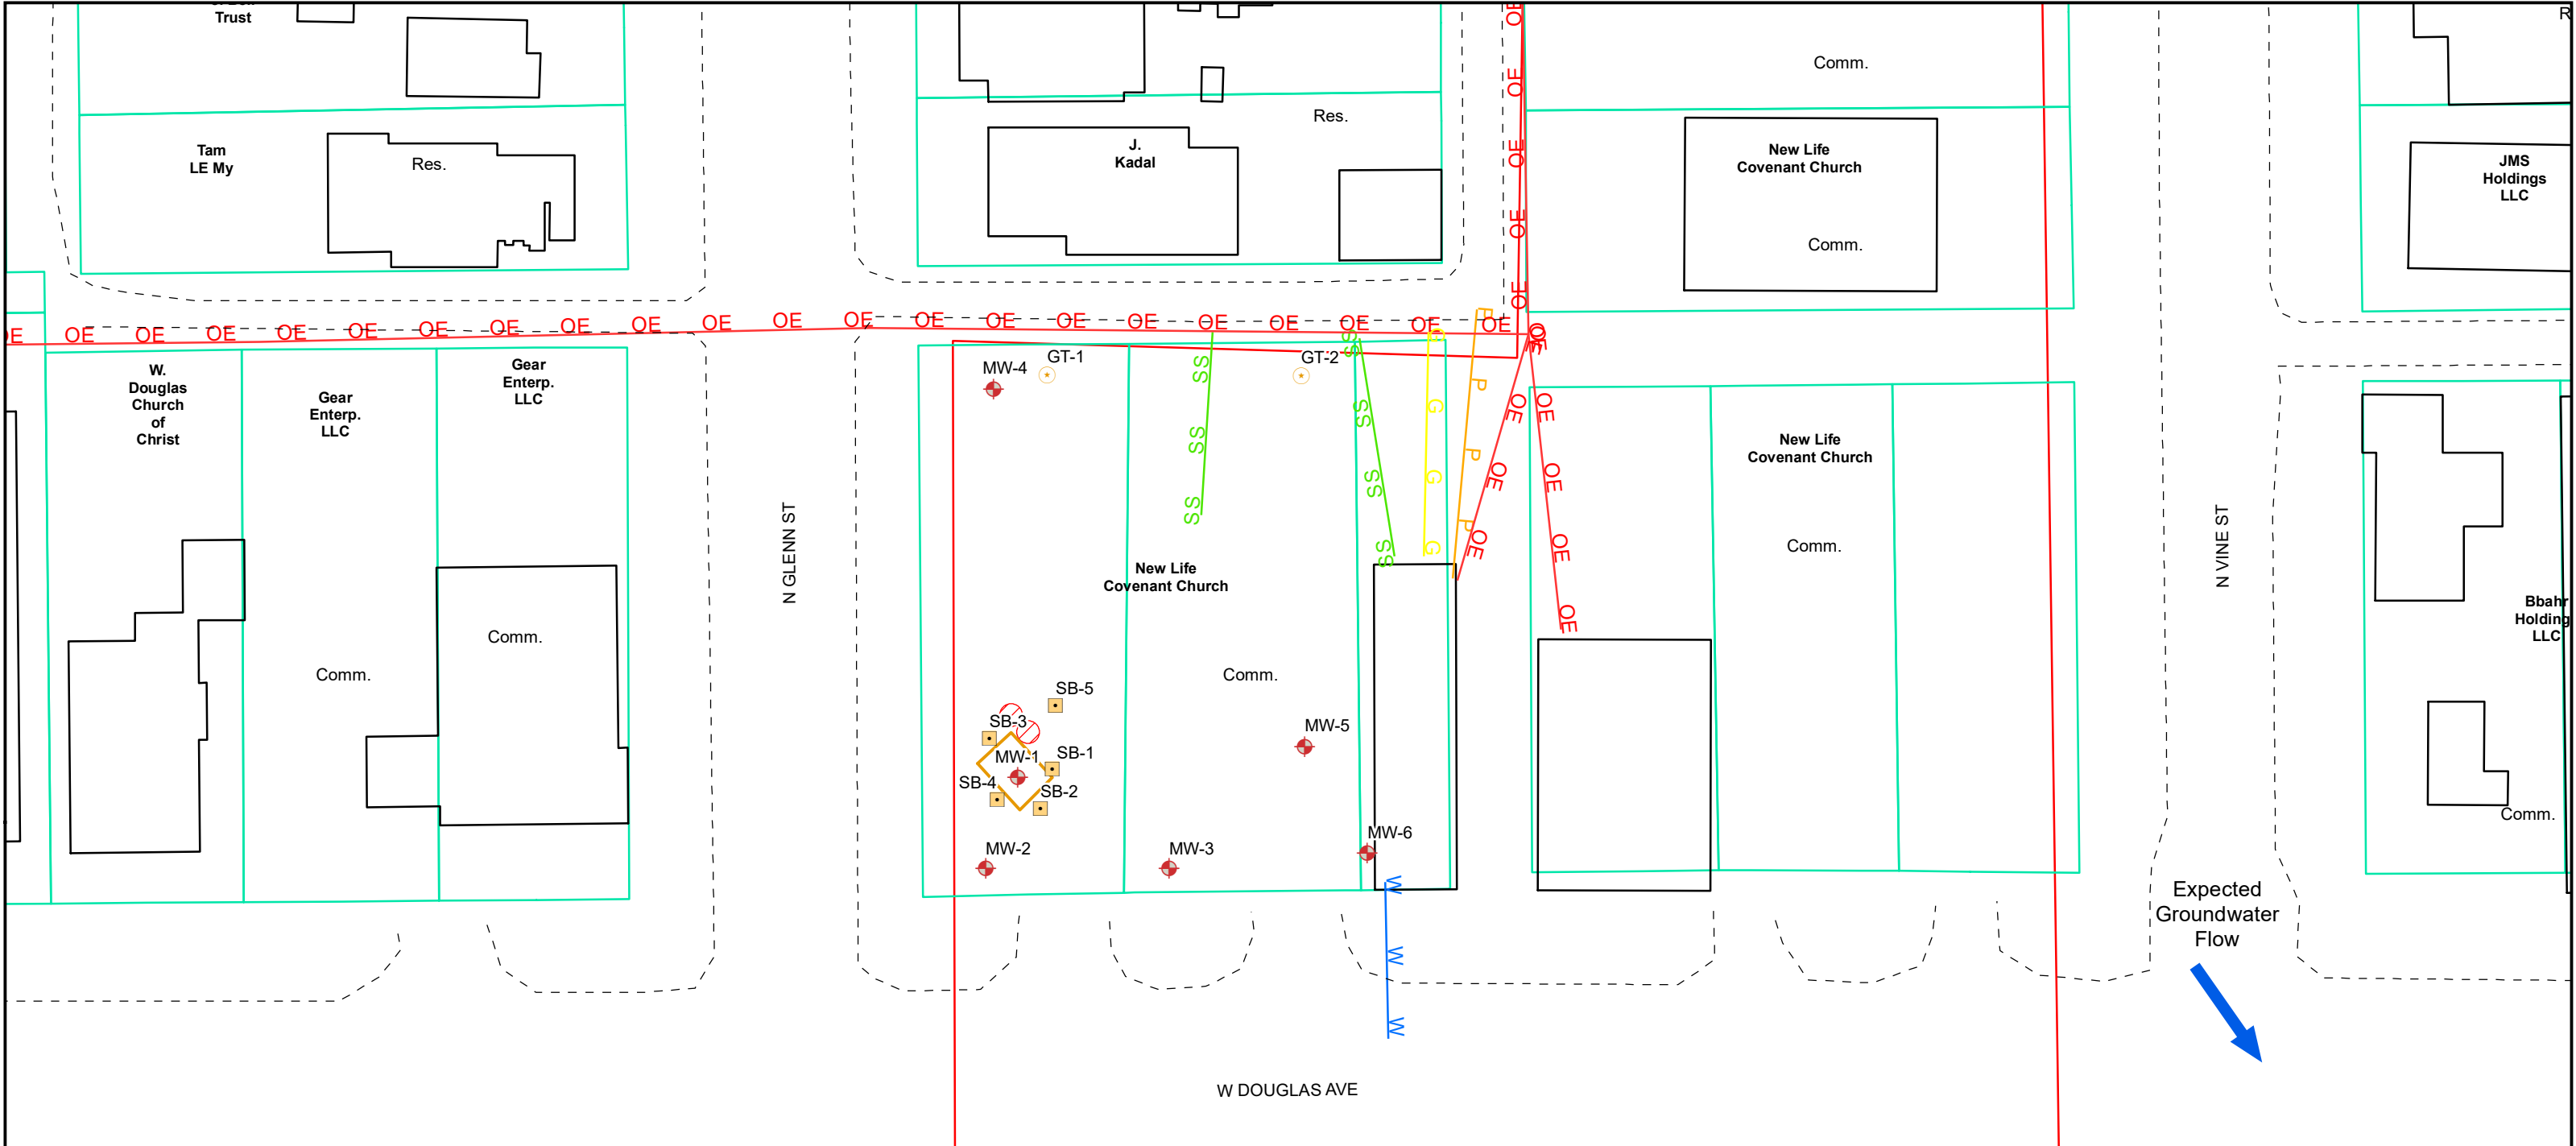

Legend

	GeoTech		Water
	Soil Borings		Overhead Electric
	Monitoring Wells		Phone
	Easements		Sewer
	Aprox Service Bldgs		Building Footprints
	UST		Parcels
	Gas		Site Boundary

ALL BOUNDARIES AND LOCATIONS ARE APPROXIMATE



FIGURE:	2.0	FIGURE NAME:	Site Base Map
DATE:	09/20/19	PROJECT NUMBER:	1974118
DRAWN BY:	CN	PROJECT MANAGER:	D.Roy

Covenant Church
1814 W, Douglas Ave.
Wichita, KS
KDHE#: U2-087-15189

