


**WATER WELL RECORD      Form WWC-5**

☐ Original Record    ☐ Correction    ☐ Change in Well Use

Division of Water  
Resources App. No.

Well ID

[illegible]

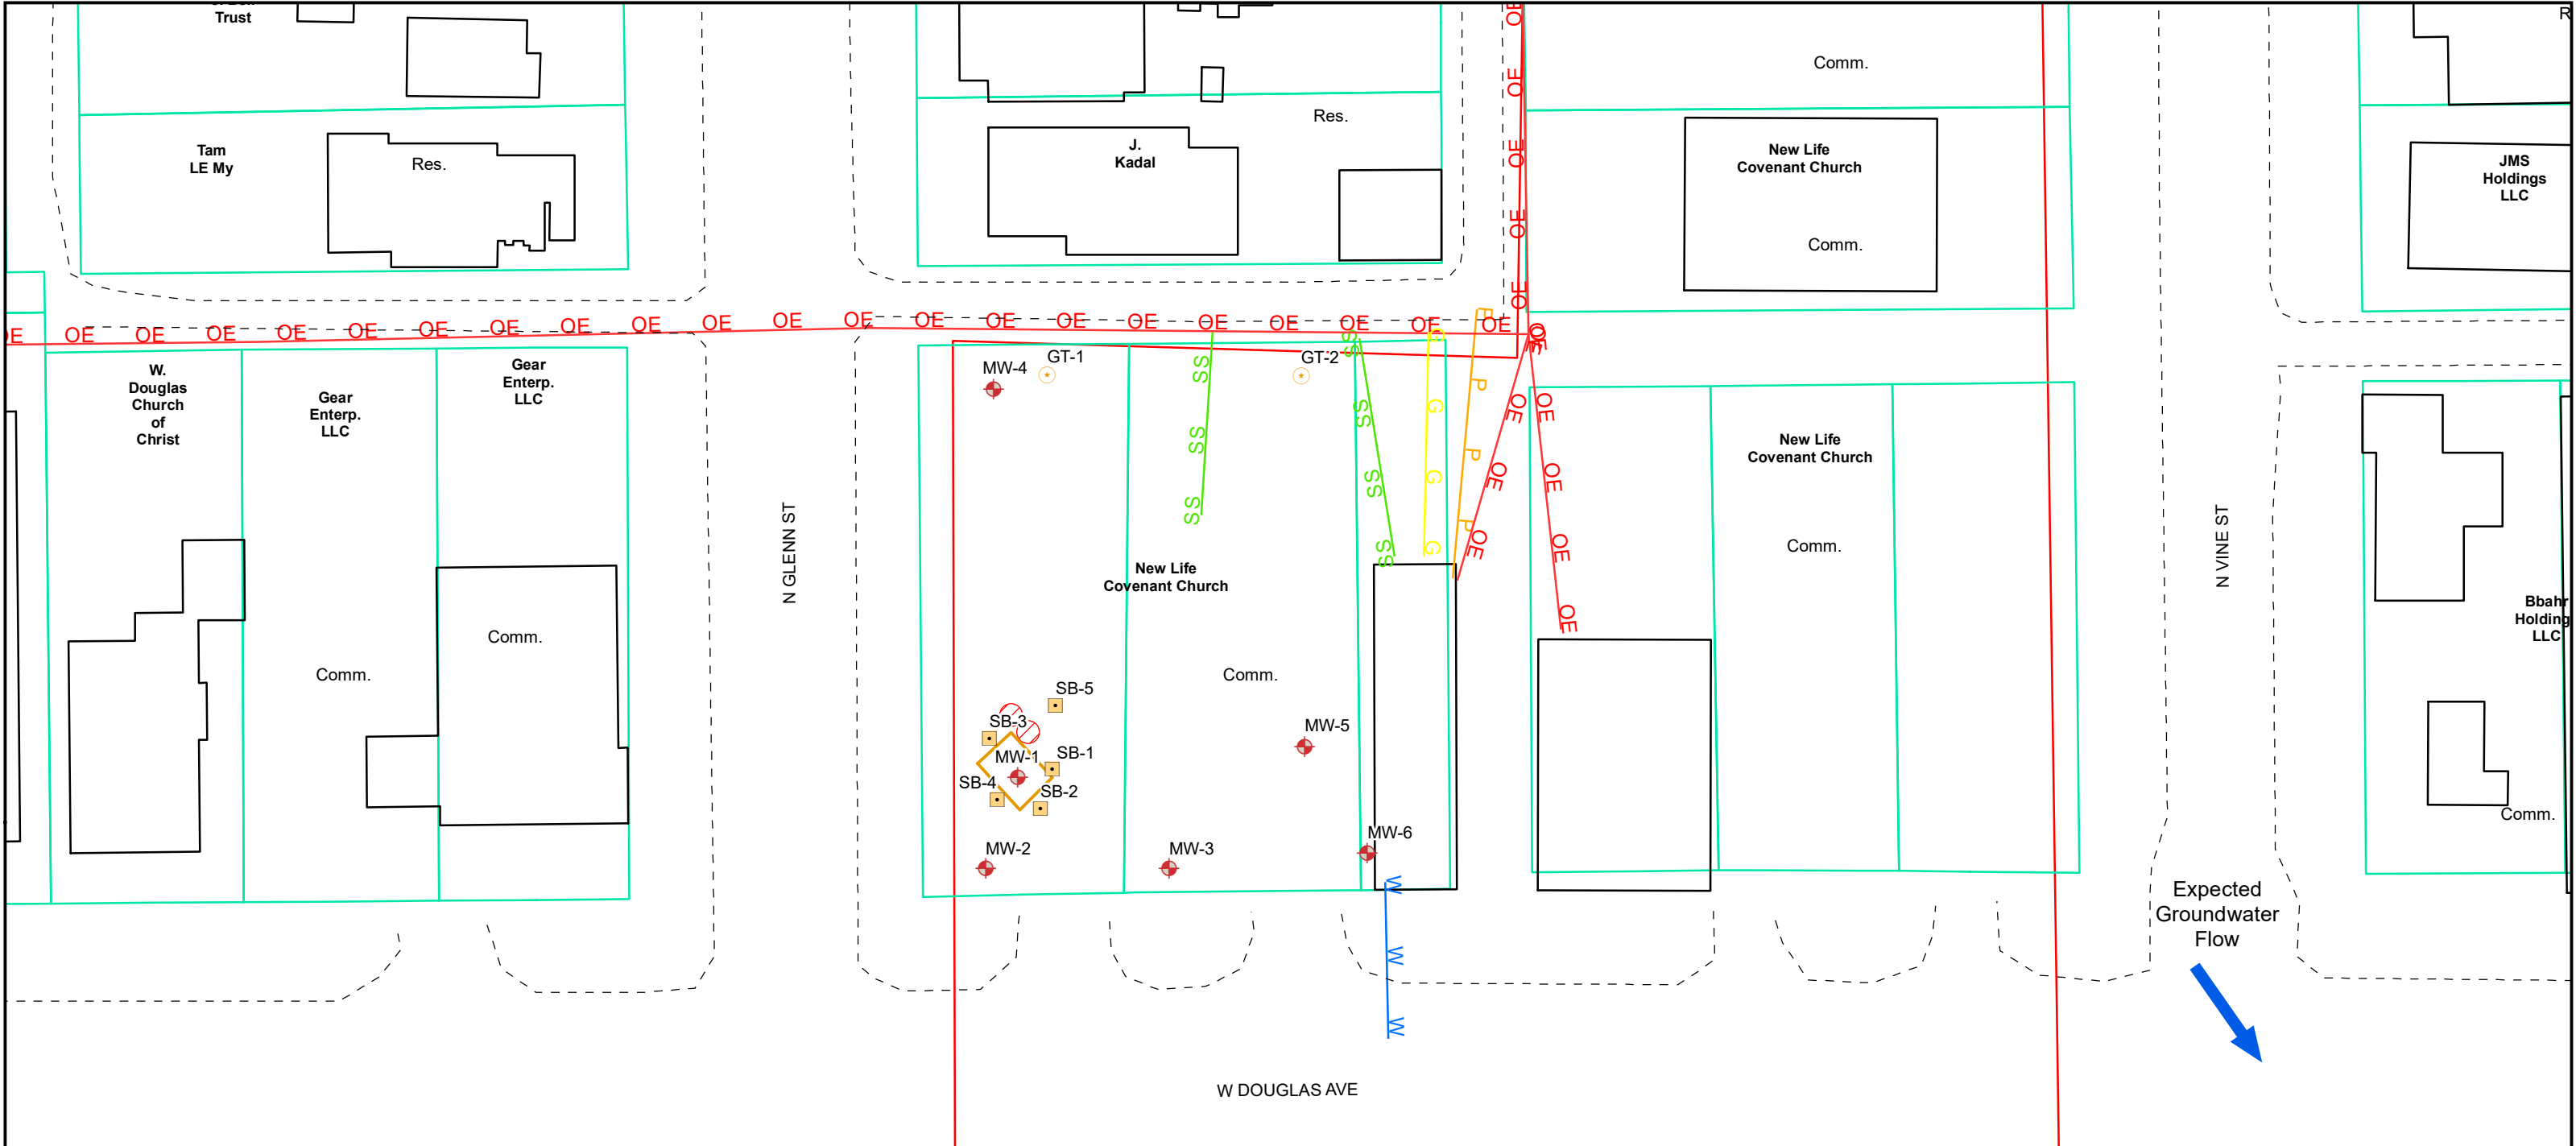

### Legend

	GeoTech		Water
	Soil Borings		Overhead Electric
	Monitoring Wells		Phone
	Easements		Sewer
	Aprox Service Bldgs		Building Footprints
	UST		Parcels
	Gas		Site Boundary

ALL BOUNDARIES AND LOCATIONS ARE APPROXIMATE



FIGURE:	<b>2.0</b>	FIGURE NAME:	<b>Site Base Map</b>
DATE:	<b>09/20/19</b>	PROJECT NUMBER:	<b>1974118</b>
DRAWN BY:	<b>CN</b>	PROJECT MANAGER:	<b>D.Roy</b>

**Covenant Church**  
**1814 W, Douglas Ave.**  
**Wichita, KS**  
**KDHE#: U2-087-15189**

