

**WATER WELL RECORD      Form WWC-5**

☐ Original Record    ☐ Correction    ☐ Change in Well Use

Division of Water  
Resources App. No.

Well ID

[illegible]




## Legend

- ★ = Dry Cleaner Sites
- ⛔ = Proposed Monitoring Well Locations
- ▲ = Existing Monitoring Wells

ALL LOCATIONS AND BOUNDARIES ARE APPROXIMATE

- 


SITE BASE MAP WITH  
PROPOSED MONITORING  
WELL LOCATIONS

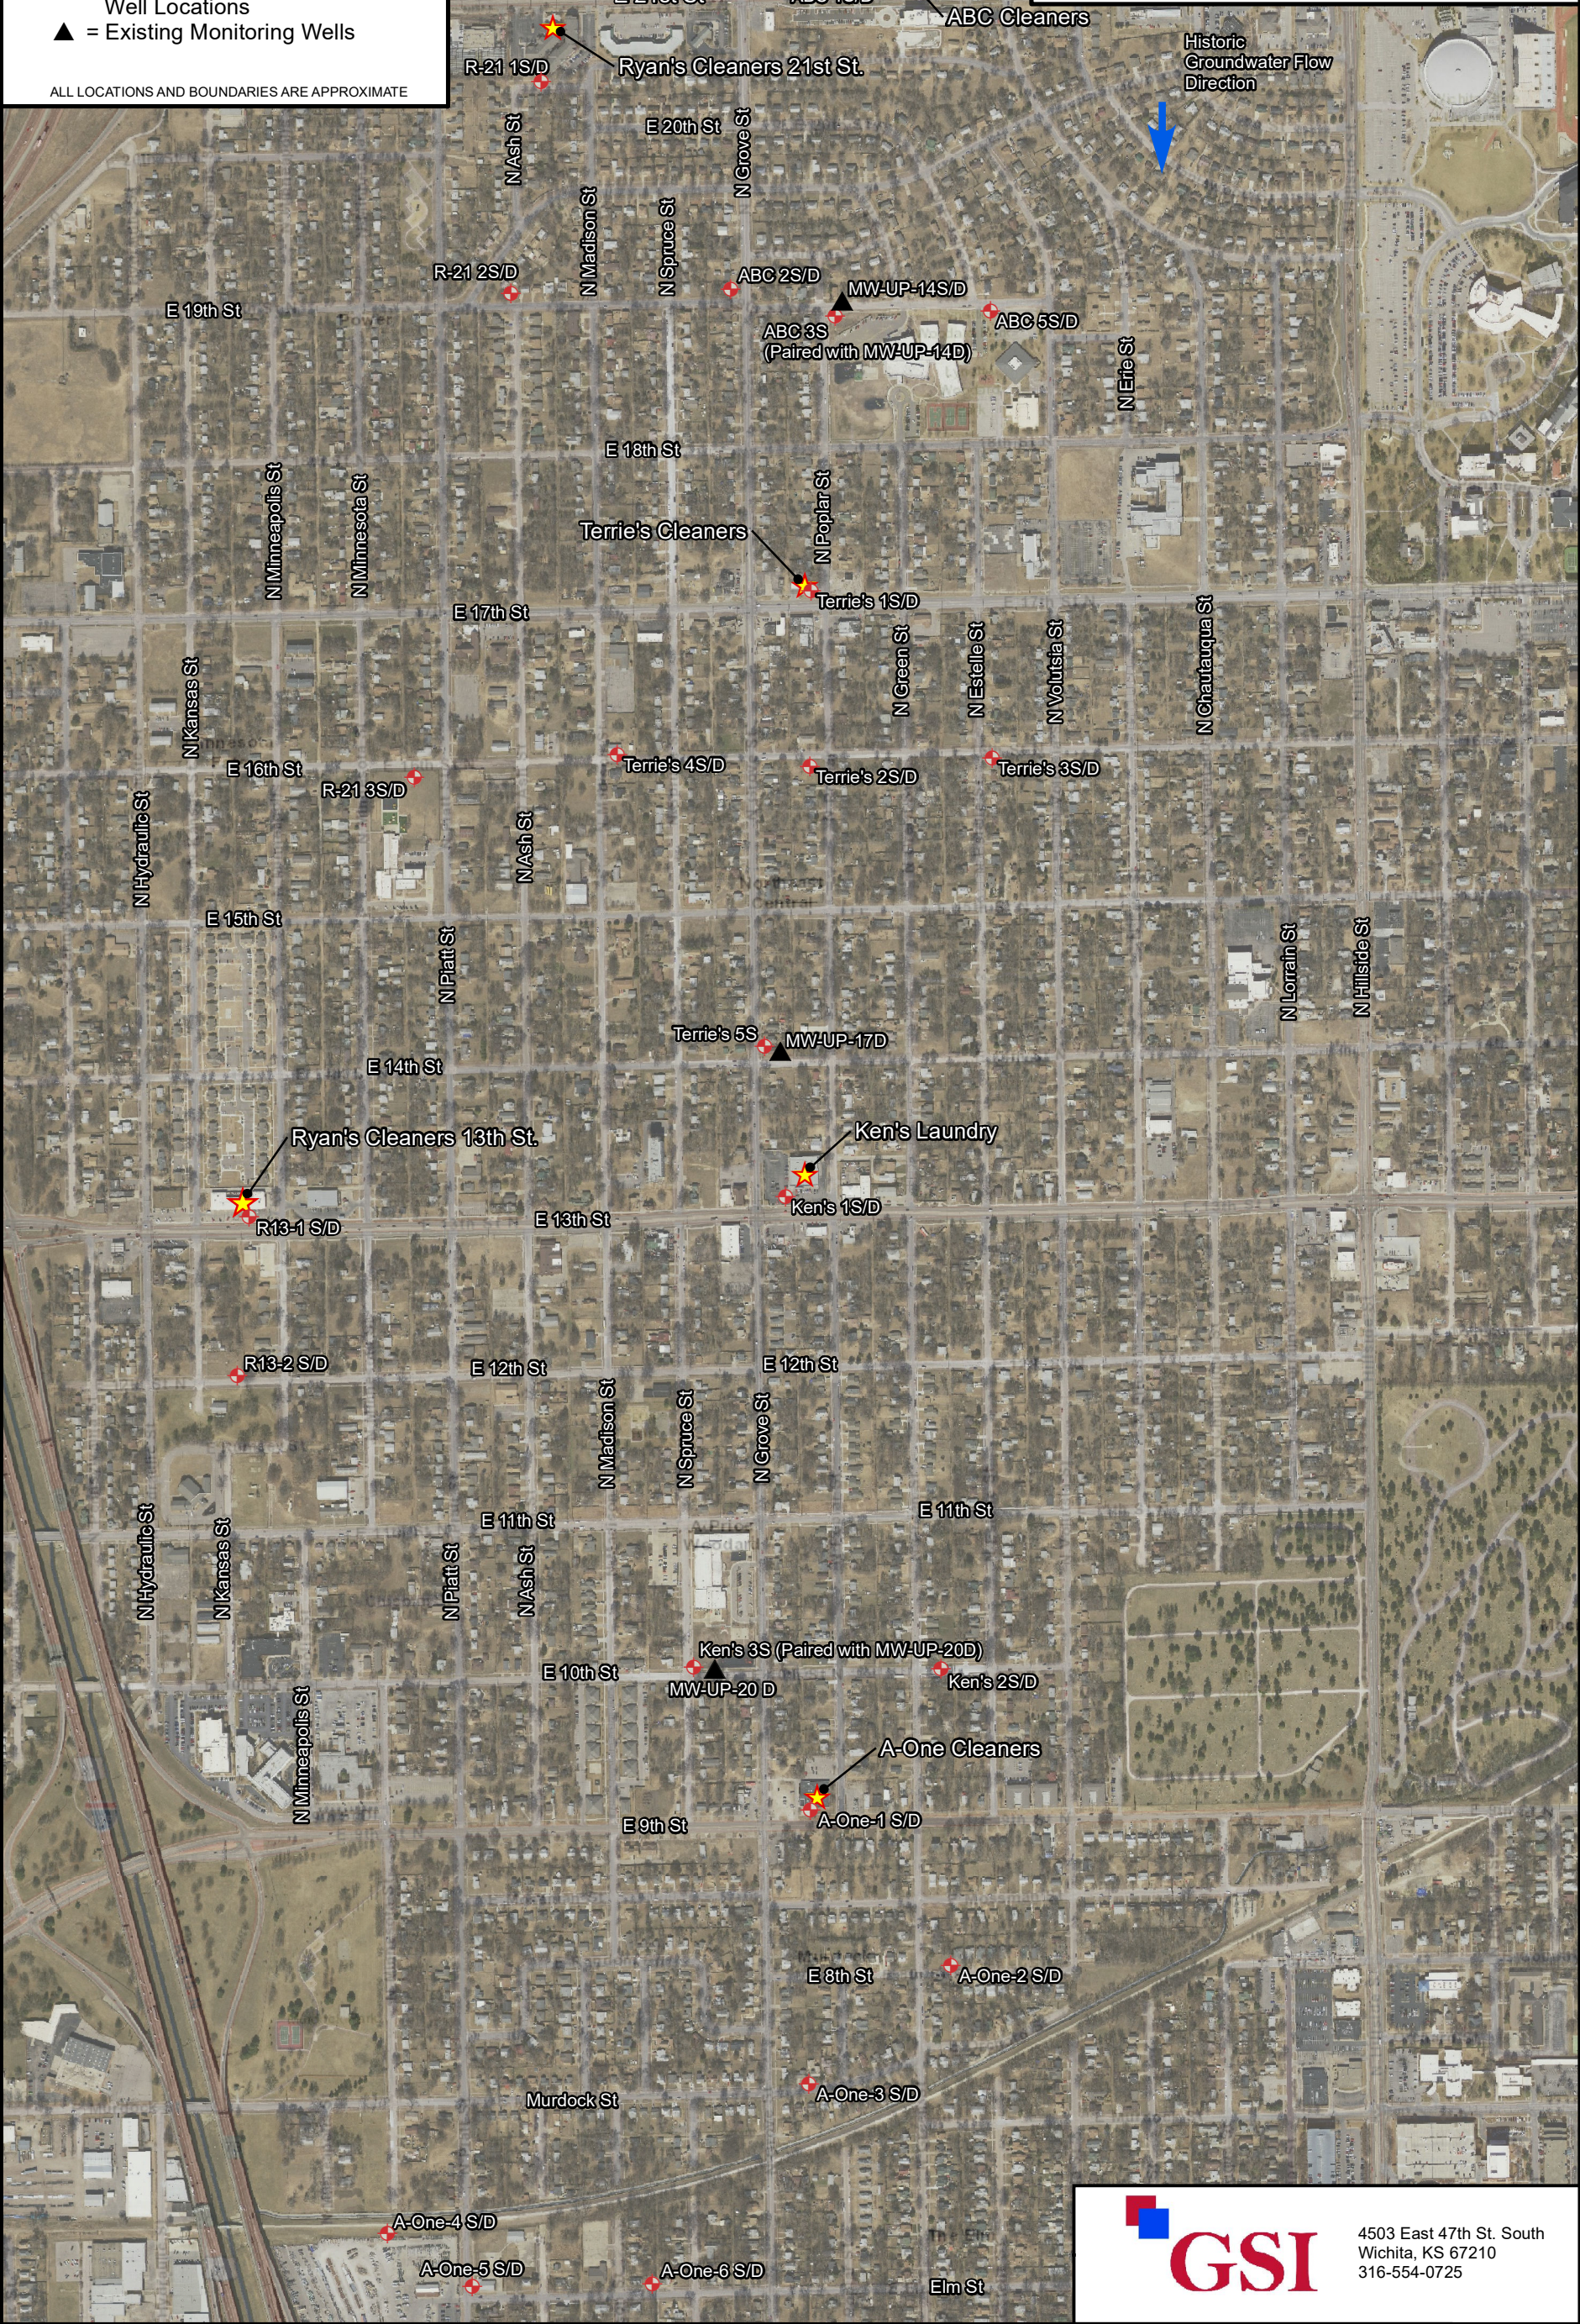

|                       |                   |                 |
|-----------------------|-------------------|-----------------|
| PROJECT #:<br>1874235 | DRAWN BY:<br>CD   | FIGURE<br><br>2 |
| DATE:<br>2019-01-10   | PROJ. MNGR:<br>KW |                 |

19th & Grove Dry Cleaners Sites  
Wichita, Kansas

FIGURE  
2