

WATER WELL RECORD Form WWC-5

☐ Original Record ☐ Correction ☐ Change in Well Use

Division of Water
Resources App. No.

Well ID

[illegible]


Legend

- ★ = Dry Cleaner Sites
- ⛔ = Proposed Monitoring Well Locations
- ▲ = Existing Monitoring Wells

ALL LOCATIONS AND BOUNDARIES ARE APPROXIMATE

-


SITE BASE MAP WITH
PROPOSED MONITORING
WELL LOCATIONS

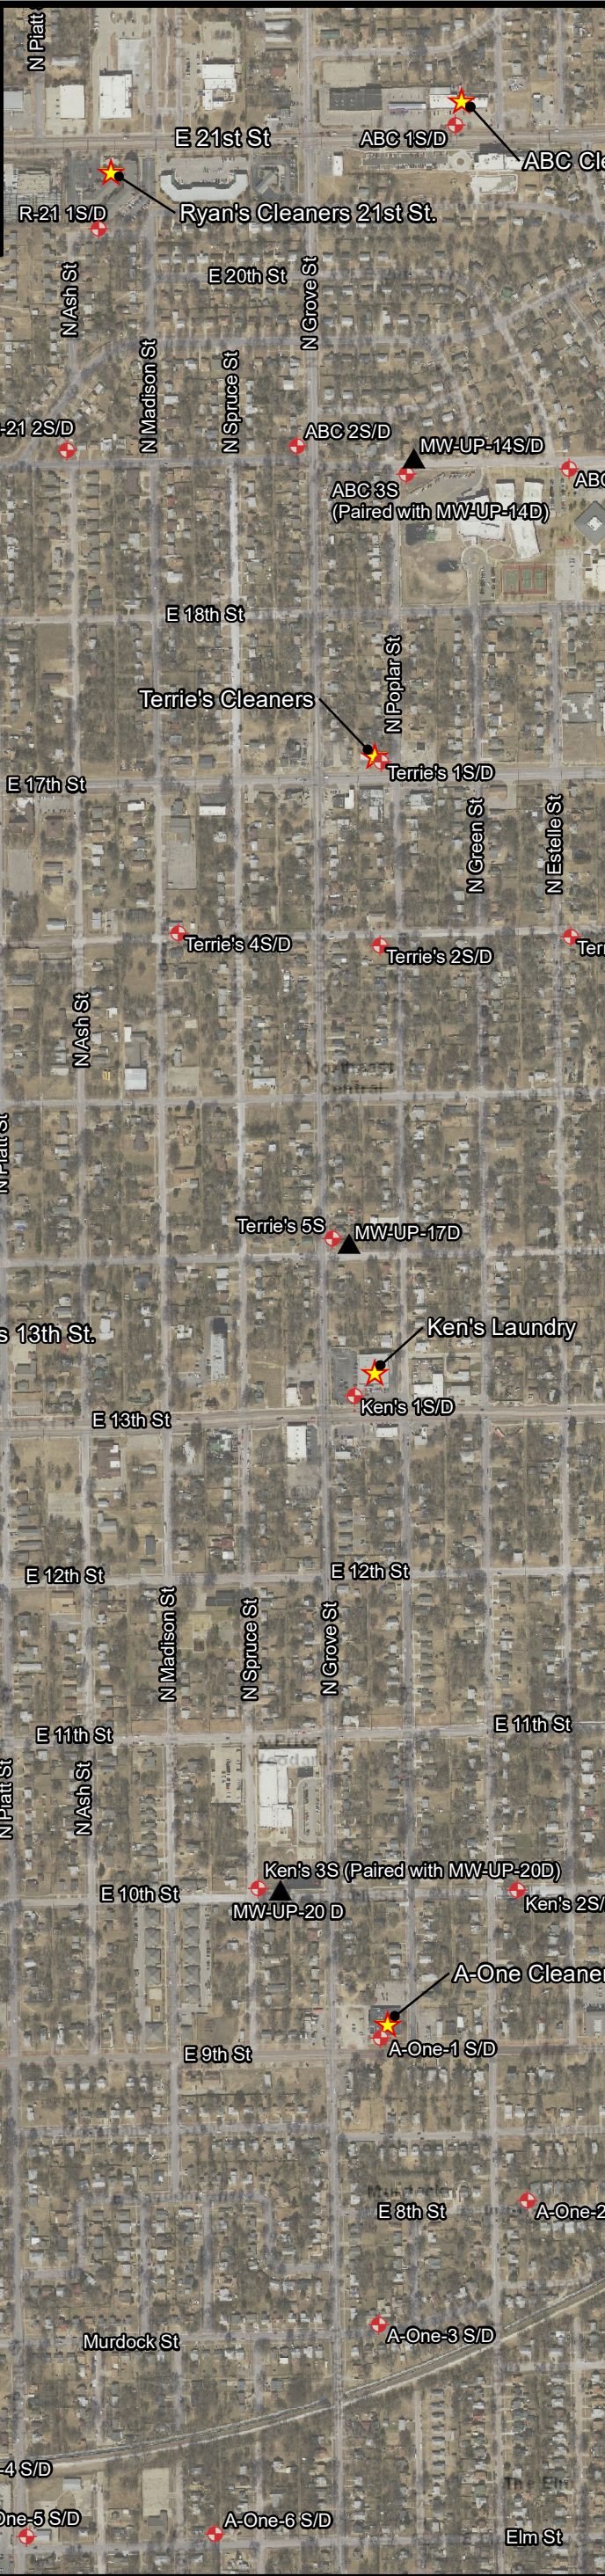

PROJECT #: 1874235	DRAWN BY: CD	FIGURE 2
DATE: 2019-01-10	PROJ. MNGR: KW	

19th & Grove Dry Cleaners Sites
Wichita, Kansas

FIGURE
2