

WATER WELL RECORD Form WWC-5

☐ Original Record ☐ Correction ☐ Change in Well Use

Division of Water
Resources App. No.

Well ID

[illegible]


Legend

- ★ = Dry Cleaner Sites
- ⛔ = Proposed Monitoring Well Locations
- ▲ = Existing Monitoring Wells

ALL LOCATIONS AND BOUNDARIES ARE APPROXIMATE

-

SITE BASE MAP WITH
PROPOSED MONITORING
WELL LOCATIONS

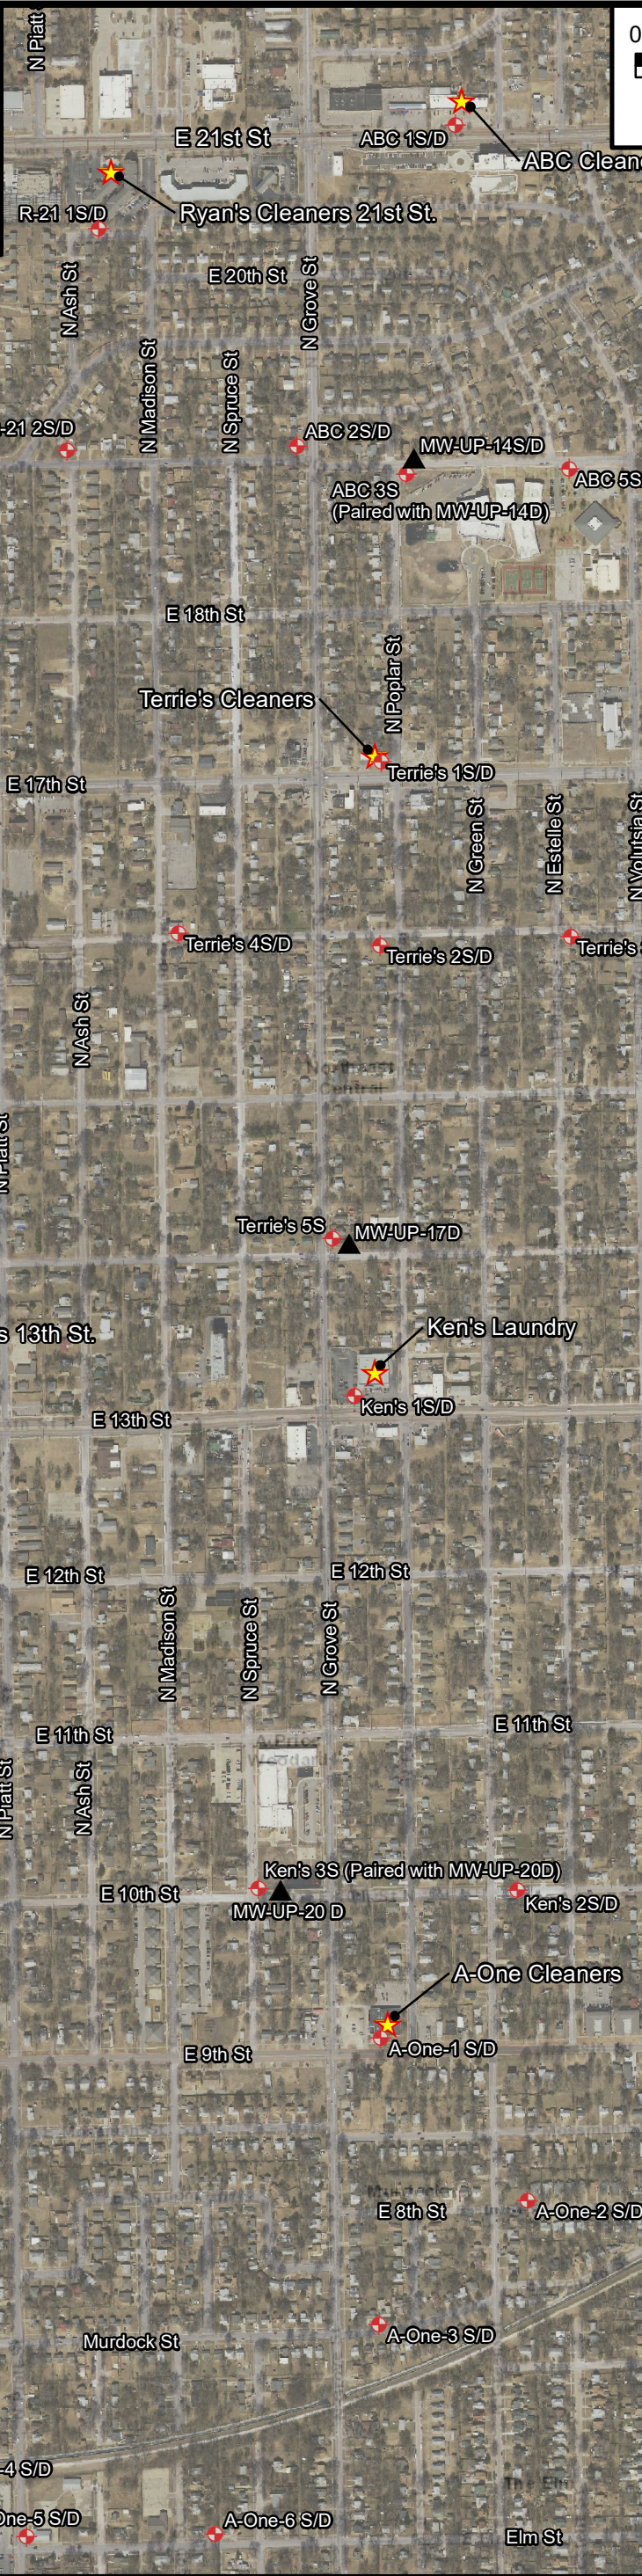

| | |
|------------|------------|
| PROJECT #: | 1874235 |
| DATE: | 2019-01-10 |

| | |
|-------------|----|
| DRAWN BY: | CD |
| PROJ. MNGR: | KW |

FIGURE
2