

WATER WELL RECORD Form WWC-5

☒ Original Record ☐ Correction ☐ Change in Well Use

Division of Water
Resources App. No.

A-One 1D

Well ID

[illegible]


Legend

- ★ = Dry Cleaner Sites
- ⛔ = Proposed Monitoring Well Locations
- ▲ = Existing Monitoring Wells

ALL LOCATIONS AND BOUNDARIES ARE APPROXIMATE

-


SITE BASE MAP WITH
PROPOSED MONITORING
WELL LOCATIONS

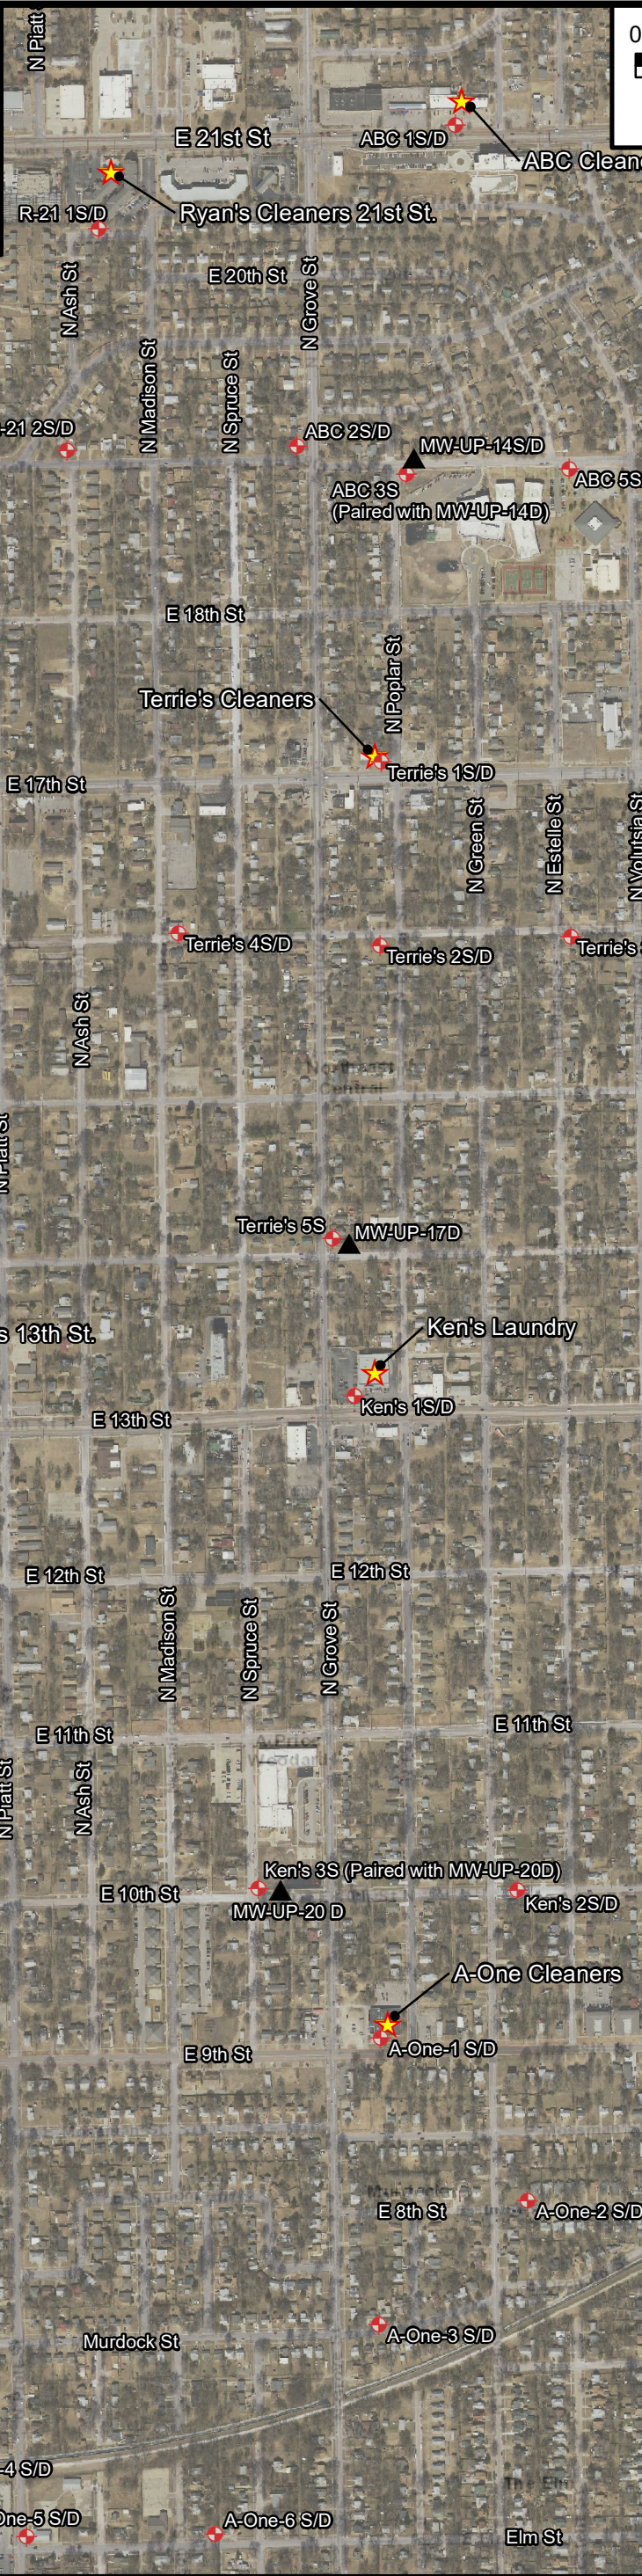

PROJECT #:	1874235
DATE:	2019-01-10

DRAWN BY:	CD
PROJ. MNGR:	KW

FIGURE
2