

**WATER WELL RECORD      Form WWC-5**

☐ Original Record    ☐ Correction    ☐ Change in Well Use

Division of Water  
Resources App. No.

Well ID

[illegible]




## Legend

- ★ = Dry Cleaner Sites
- ⛔ = Proposed Monitoring Well Locations
- ▲ = Existing Monitoring Wells

ALL LOCATIONS AND BOUNDARIES ARE APPROXIMATE

- 


SITE BASE MAP WITH  
PROPOSED MONITORING  
WELL LOCATIONS

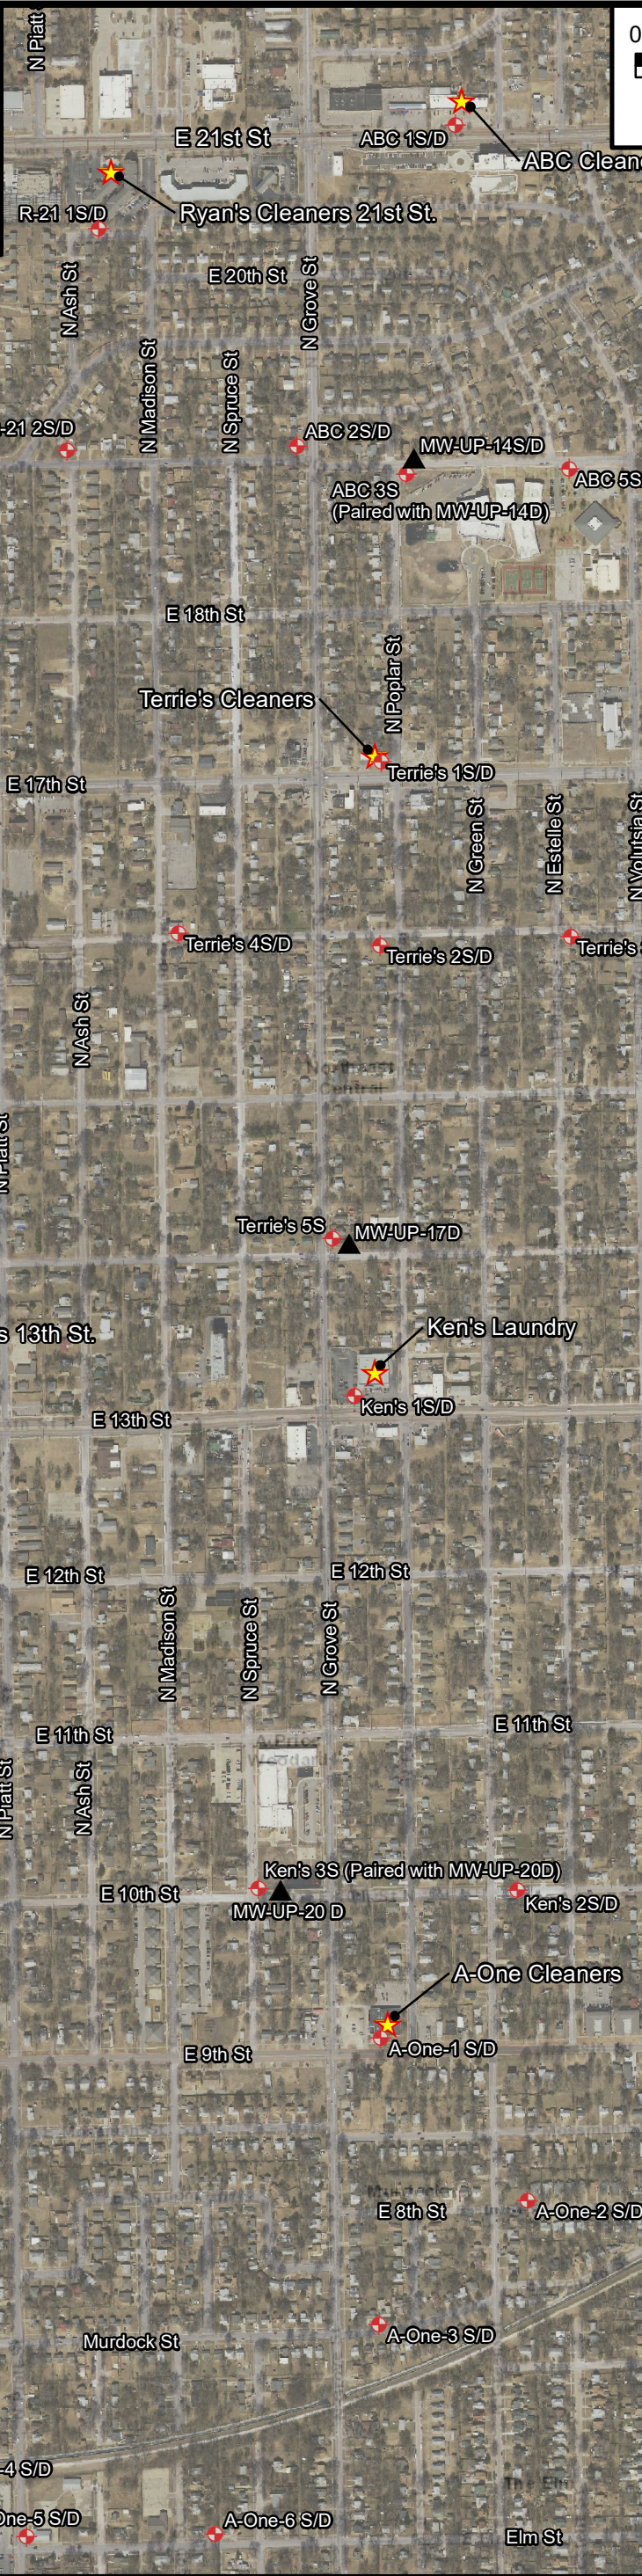

PROJECT #: 1874235	DRAWN BY: CD	FIGURE  2
DATE: 2019-01-10	PROJ. MNGR: KW	