

## WATER WELL PLUGGING RECORD

Form WWC-5P

KSA 82a-1212

ID NO.

MW2

## 1 LOCATION OF WATER WELL:

County: Sedgwick

Fraction

SW 1/4 SW 1/4 SW 1/4 NE 1/4

Section Number

6

Township Number

T 27 S

Range Number

I ☒ E ☐ W

Street/Rural Address of Well Location; if unknown, distance & direction from nearest town or intersection: If at owner's address, check here ☐

2600 N Amidon, Wichita KS

## Global Positioning Systems (GPS) information:

Latitude: 37.73017 (in decimal degrees)

Longitude: 97.36271 (in decimal degrees)

Elevation: NA

Horizontal Datum ☐ WGS84, ☒ NAD83, ☐ NAD27

Collection Method:

☐ GPS unit (Make/model: \_\_\_\_\_)☐ Digital Map/Photo, ☐ Topographic Map ☐ Land SurveyEst. Accuracy: ☐ <3 m, ☐ 3-5 m, ☐ 5-15 m, ☐ >15 m

## 2 WATER WELL OWNER:

KDHE


RR#, St. Address, Box #:

1000 SW Jackson Blvd

City, State ZIP Code:

Topeka, KS 66612

## 3 MARK WELL'S LOCATION WITH AN "X" IN SECTION BOX:

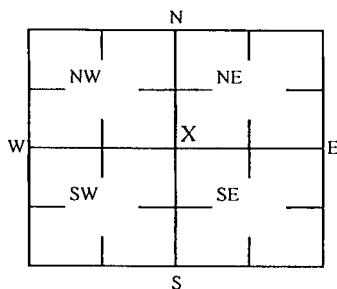

## 4 DEPTH OF WELL 23.8 ft. MW2

WELL'S STATIC WATER LEVEL NA ft

WELL WAS USED AS:

☐ Domestic  
☐ Irrigation  
☐ Feedlot  
☐ Industrial

☐ Public Water Supply  
☐ Oil Field Water Supply  
☐ Domestic (Lawn & Garden)  
☐ Air Conditioning

☐ Dewatering  
☒ Monitoring  
☐ Injection Well  
☐ Other \_\_\_\_\_

Was a chemical/bacteriological sample submitted to Department?

Yes ☐ No ☒

## 5 TYPE OF BLANK CASING USED:

☐ Steel  
☒ PVC

☐ RMP (SR)  
☐ ABS

☐ Wrought  
☐ Asbestos-Cement

☐ Fiberglass  
☐ Concrete Tile
☐ Other (Specific below) \_\_\_\_\_

Blank casing diameter 2 in.

Casing height above or below land surface

Was casing pulled? Yes ☒ No ☐

NA in.

If yes, how much 3'

## 6 GROUT PLUG MATERIAL:

☐ Neat cement☐ Cement grout☒ Bentonite☒ Other

Concrete: 0-0.5'; Soil: 0.5'-3'

Grout Plug Intervals: From 3 ft to 23.8 ft, From \_\_\_\_\_ ft to \_\_\_\_\_ ft, From \_\_\_\_\_ ft to \_\_\_\_\_ ft,

What is the nearest source of possible contamination:

☐ Septic tank  
☐ Sewer lines  
☐ Watertight sewer lines  
☐ Lateral lines  
☐ Cess pool

☐ Seepage pit  
☐ Pit privy  
☐ Sewage lagoon  
☐ Feed yard  
☐ Livestock pens

☐ Fuel storage  
☐ Fertilizer storage  
☐ Insecticide storage  
☐ Abandoned water well  
☐ Oil well/Gas well
☐ Other (specify below) \_\_\_\_\_

Direction from well? \_\_\_\_\_

How many feet? \_\_\_\_\_

FROM	TO	PLUGGING MATERIALS	FROM	TO	PLUGGING MATERIALS
0	0.5	Concrete			
0.5	3	Soil			
3	23.8	Bentonite			

KDHE ID: Amidon 66 Service; U2-087-14460

## 7 CONTRACTOR'S OR LANDOWNER'S CERTIFICATION:

This water well was plugged under my jurisdiction and was completed on (mo/day/year) 4/8/2020 and this record is true to the best of my knowledge and belief. Kansas Water

Contractor's License No. 757. This Water Well Record was completed on (mo/day/year) 4/10/2020 under the

business name of Larsen & Associates, Inc. By (signature) \_\_\_\_\_

Send one white copy to Kansas Department of Health & Environment, Geology Section, 1000 SW Jackson Street, Ste. 420, Topeka, KS 66612-1367. Send one copy to WATER WELL OWNER and retain one for your records

Visit us at <http://www.kdheks.gov/waterwell/index.html> Telephone 785-296-5524.

KSA82a-1212

Revised 1/20/2015