

WATER WELL RECORD Form WWC-5

Original Record Correction Change in Well Use


Division of Water Resources App. No.

Well ID

NMW-43DR

1 LOCATION OF WATER WELL: County: Sedgwick Fraction NW 1/4 SW 1/4 SW 1/4 SE 1/4 Section Number 4 Township Number T 27 S Range Number R 1 E W

2 WELL OWNER: Last Name: City of Wichita/Environmental Health First: Address: 455 N. Main Street or Rural Address where well is located: 2461 N. New York St. Wichita, KS. well located on the SW side of the property.

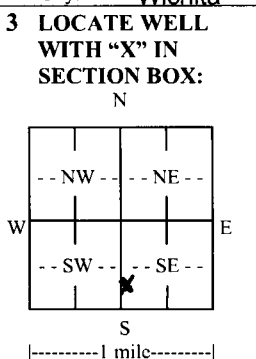

3 LOCATE WELL WITH 'X' IN SECTION BOX: N, W, E, S, 1/4 mile. 4 DEPTH OF COMPLETED WELL: 39.5 ft. Depth(s) Groundwater Encountered: 1) 12 ft. 2) ... 3) ... 4) Dry Well. WELL'S STATIC WATER LEVEL: 14.80 ft. below land surface, measured on (mo-day-yr) 4/30/2020.

5 Latitude: 37.72465 (decimal degrees) Longitude: 97.32545 (decimal degrees) Horizontal Datum: WGS 84. Source for Latitude/Longitude: GPS (unit make/model: garmen c60).

6 Elevation: ... ft. Ground Level TOC Source: Land Survey GPS Topographic Map Other.

7 WELL WATER TO BE USED AS: 1. Domestic: Household, Lawn & Garden, Livestock, Irrigation, Feedlot, Industrial. 2. Public Water Supply: well ID. 3. Dewatering: how many wells? 4. Aquifer Recharge: well ID. 5. Monitoring: well ID NMW-43DR. 6. Environmental Remediation: well ID. 7. Air Sparge, Soil Vapor Extraction, Recovery, Injection. 8. Oil Field Water Supply: lease. 9. Test Hole: well ID. 10. Geothermal: how many bores? 11. Closed Loop, Horizontal, Vertical. 12. Open Loop, Surface Discharge, Inj. of Water. 13. Other (specify):

Was a chemical/bacteriological sample submitted to KDHE? Yes No. If yes, date sample was submitted: Water well disinfected? Yes No.

8 TYPE OF CASING USED: Steel PVC Other. CASING JOINTS: Glued Clamped Welded Threaded. Casing diameter 1.25 in. to 2.95 ft. Diameter in. to ft. Casing height above land surface 30 in. Weight lbs./ft. Wall thickness or gauge No. Sch. 40. TYPE OF SCREEN OR PERFORATION MATERIAL: Steel Stainless Steel Fiberglass PVC Other (Specify). SCREEN OR PERFORATION OPENINGS ARE: Continuous Slot Mill Slot Gauze Wrapped Torch Cut Drilled Holes Other (Specify). Louvered Shutter Key Punched Wire Wrapped Saw Cut None (Open Hole). SCREEN-PERFORATED INTERVALS: From 29.5 ft. to 39.5 ft. GRAVEL PACK INTERVALS: From 25.5 ft. to 39.5 ft.

9 GROUT MATERIAL: Neat cement Cement grout Bentonite Other. Grout Intervals: From 2 ft. to 25.5 ft. From ft. to ft. From ft. to ft.

Nearest source of possible contamination: Septic Tank Lateral Lines Pit Privy Livestock Pens Insecticide Storage. Sewer Lines Cess Pool Sewage Lagoon Fuel Storage Abandoned Water Well. Watertight Sewer Lines Seepage Pit Feedyard Fertilizer Storage Oil Well/Gas Well. Other (Specify): Direction from well? Distance from well? ft.

Table with 6 columns: 10 FROM, TO, LITHOLOGIC LOG, FROM, TO, LITHO. LOG (cont.) or PLUGGING INTERVALS. Rows include Silty Clay (0-2), Clay (2-16), Sand (16-39), and Shale (39-). Notes: Lithologic log based on Electrical Conductivity logging data.

11 CONTRACTOR'S OR LANDOWNER'S CERTIFICATION: This water well was constructed, reconstructed, or plugged under my jurisdiction and was completed on (mo-day-year) 4/29/2020 and this record is true to the best of my knowledge and belief. Kansas Water Well Contractor's License No. 710. This Water Well Record was completed on (mo-day-year) 5/11/2020 under the business name of Below Ground Surface, Inc. Signature

Mail 1 white copy along with a fee of \$5.00 for each constructed well to: Kansas Department of Health and Environment, Bureau of Water, GWTS Section, 1000 SW Jackson St., Suite 420, Topeka, Kansas 66612-1367. Mail one to Water Well Owner and retain one for your records. Telephone 785-296-5524. Visit us at http://www.kdheks.gov/waterwell/index.html KSA 82a-1212 Revised 7/10/2015