
W	ATER WELL PLUGGING	RECORD	Form W	WC-5P	KSA 82	2a-1212 III	NO.	RW-06	
1	LOCATION OF WATER WELL:	Fraction		Section	on Number	Township N		Range Number	
-	County: Sedgwick Street/Rural Address of Well Location;	SW 1/4 SE	1/4 SW 1/4 SE		Da aidi a mia.	T 27	S	1 7 E W	
	direction from nearest town or intersect	Latitude	Global Positioning Systems (GPS) information: Latitude: 37.7227603 (in decimal degrees)						
l	check here Former Coastal Refinery, 2461 N. New York				Longitude: -97.32356898 (in decimal degrees)				
	Street, Wichita, K	Elevation	Elevation: 1312.35 Horizontal Datum: WGS84, NAD83, NAD27						
					Horizontal Datum: WGS84, NAD83, NAD27				
2	WATER WELL OWNER: El Paso, LLC				GPS unit (Make/Model:				
	RR#, St. Address, Box #: 1515 Des Peres Road Suite 300				GPS unit (Make/Model: Digital Map/Photo, Topographic Map, Land Survey				
	City, State ZIP Code: St. Louis, MO. 63131				Est. Accuracy: \square < 3 m, \square 3-5 m, \square 5-15 m, \square > 15 m				
3								5 15 III,	
	WITH AN "X" IN SECTION	I AN "X" IN SECTION							
	BOX: WELL'S STATIC WATER LEVEL 15.23 ft								
	WELL WAS USED AS:								
	NW NE	Dom Dom	estic [Public	Water Suppl	ly 🗍	Dewate	ering	
u	W Irrigation ☐ Oil Field Water Supply ✓ Monitoring							oring	
, ,	Domestic (Lawn & Garden) Injection Well								
	312							1	
	Was a chemical/bacteriological sample submitted to Department? Yes No 🗸								
5	5 TYPE OF BLANK CASING USED:								
	Steel RMP (SR) Wrought Fiberglass Other (Specify below) ABS Asbestos-Cement Concrete Tile								
Concrete The									
Blank casing diameter 12 in. Was casing pulled? Yes No I If yes, how much 5.5 ft.									
Casing height above or below land surface 30 in.									
6 GROUT PLUG MATERIAL: Neat cement Cement grout Bentonite Other									
	Grout Plug Intervals: From 0 ft. to 31.00 ft., From ft. to ft., From ft. to ft.								
	What is the nearest source of possible contamination: Septic tank Seepage pit The laterage The Other (checify below)								
	Cower lines Vines (specify below)								
	Watertight sewer lines Sewage lagoon Insecticide storage								
	Lateral lines Feedyard Abandoned water well Direction from well? NA								
		ll/Gas well	Gas well How many feet? 0						
	FROM TO PLUG	GING MATE	RIALS	FROM	TO	PLUG	GING M	IATERIALS	
	0 31.00 Bentonite						OII (G IV	TI EIGHES	
7 (ONTDACTOR'S OR LANDOWN	IED10 CE							
7 CONTRACTOR'S OR LANDOWNER'S CERTIFICATION: This water well was plugged under my jurisdiction and was completed on (mo/day/year) 10-22-2020 and this record is true to the best of my knowledge and belief. Kenses With									
Well Contractor's License No. 604 This Water Well Record was completed on (mg/dw/sear). A difference was completed on (mg/dw/sear).									
business name of Environmental Priority Service, Inc. by (signature) 4 to 12 17 2020 under the									
Sen	d one white conv to Kansas Departm	ent of Health	& Envisor	+ C1	G)	<u> </u>		
Send one white copy to Kansas Department of Health & Environment, Geology Section, 1000 SW Jackson Street, Ste. 420, Topeka, KS 66612-1367. Send one copy to WATER WELL OWNER and retain one for your records.									
Visit us at http://www.kdheks.gov/waterwell/index.html Telephone 785-296-5524.									

KSA82a-1212

Revised 1/20/2015

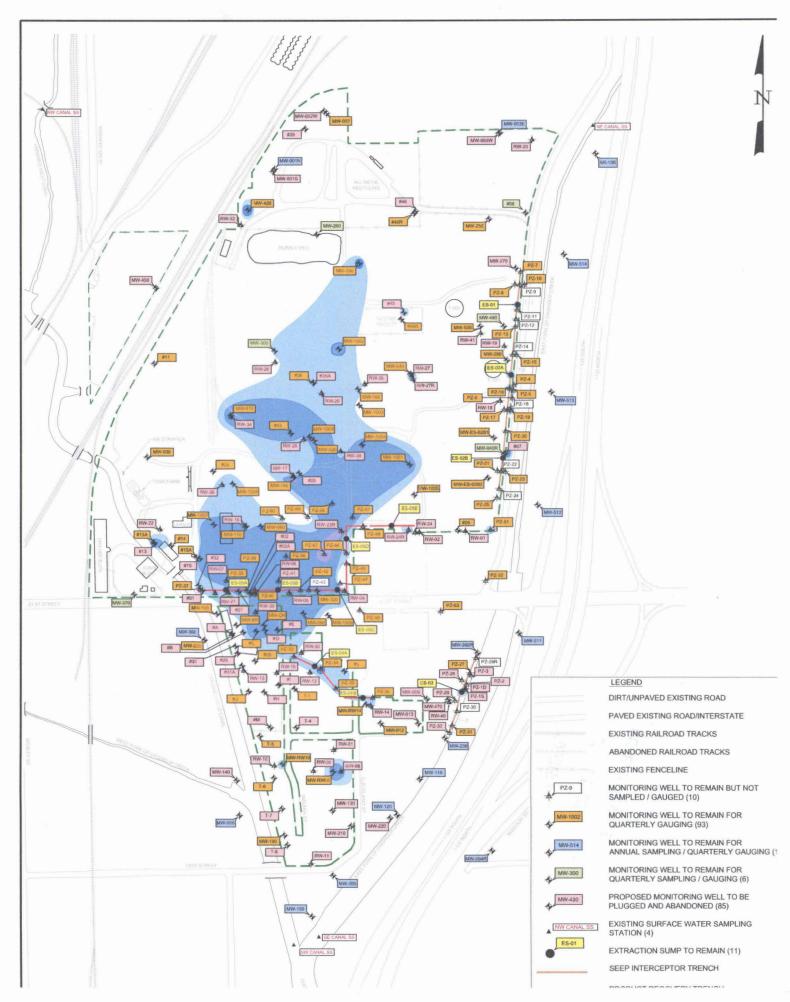

T27 R1E Sec 4 T27 R1E Sec 9

