


**1 LOCATION OF WATER WELL:**      Fraction NE ¼ SE ¼ NW ¼ NE ¼      Section Number 9      Township Number T 27 S      Range Number 1       E       W  
 County: Sedgwick

Street/Rural Address of Well Location; if unknown, distance & direction from nearest town or intersection: If at owner's address, check here  Former Coastal Refinery, 2461 N. New York Street, Wichita, Ks.

**Global Positioning Systems (GPS) information:**  
 Latitude: 37.72032314 (in decimal degrees)  
 Longitude: -97.32260133 (in decimal degrees)  
 Elevation: 1308.55  
 Horizontal Datum:  WGS84,  NAD83,  NAD27  
 Collection Method:

**2 WATER WELL OWNER:** Ei Paso, LLC  
 RR#, St. Address, Box #: 1515 Des Peres Road, Suite 300  
 City, State ZIP Code: St. Louis, MO. 63131

GPS unit (Make/Model: \_\_\_\_\_)  
 Digital Map/Photo,  Topographic Map,  Land Survey  
 Est. Accuracy:  < 3 m,  3-5 m,  5-15 m,  > 15 m

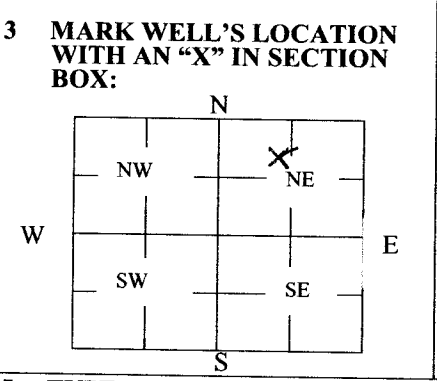

**4 DEPTH OF WELL** 27.38 **ft.**  
 WELL'S STATIC WATER LEVEL 13.33 **ft.**  
 WELL WAS USED AS:

Domestic       Public Water Supply       Dewatering  
 Irrigation       Oil Field Water Supply       Monitoring  
 Feedlot       Domestic (Lawn & Garden)       Injection Well  
 Industrial       Air Conditioning       Other recovery

Was a chemical/bacteriological sample submitted to Department? Yes  No

**5 TYPE OF BLANK CASING USED:**

Steel       RMP (SR)       Wrought       Fiberglass       Other (Specify below) \_\_\_\_\_  
 PVC       ABS       Asbestos-Cement       Concrete Tile

Blank casing diameter 12 in. Was casing pulled? Yes  No  If yes, how much 5.5 ft.  
 Casing height above or below land surface 30 in.

**6 GROUT PLUG MATERIAL:**       Neat cement       Cement grout       Bentonite       Other \_\_\_\_\_

Grout Plug Intervals: From 0 ft. to 27.38 ft., From \_\_\_\_\_ ft. to \_\_\_\_\_ ft., From \_\_\_\_\_ ft. to \_\_\_\_\_ ft.

What is the nearest source of possible contamination:

Septic tank       Seepage pit       Fuel storage       Other (specify below) contaminated site  
 Sewer lines       Pit privy       Fertilizer storage  
 Watertight sewer lines       Sewage lagoon       Insecticide storage  
 Lateral lines       Feedyard       Abandoned water well      Direction from well? NA  
 Cess pool       Livestock pens       Oil well/Gas well      How many feet? 0

FROM	TO	PLUGGING MATERIALS	FROM	TO	PLUGGING MATERIALS
0	27.38	Bentonite			

**7 CONTRACTOR'S OR LANDOWNER'S CERTIFICATION:** This water well was plugged under my jurisdiction and was completed on (mo/day/year) 10-27-2020 and this record is true to the best of my knowledge and belief. Kansas Water Well Contractor's License No. 604. This Water Well Record was completed on (mo/day/year) 12/7/2020 under the business name of Environmental Priority Service, Inc. by (signature) [Signature]

Send one white copy to Kansas Department of Health & Environment, Geology Section, 1000 SW Jackson Street, Ste. 420, Topeka, KS 66612-1367. Send one copy to WATER WELL OWNER and retain one for your records.  
 Visit us at <http://www.kdheks.gov/waterwell/index.html> Telephone 785-296-5524.

