
W	ATER WELL PLUGGING I	RECORD	Form WV	VC-5P	KSA 83	2a-1212 ID NO.	RW-18	
1	LOCATION OF WATER WELL:	Fraction		Section	n Number	Township Number	Range Number	
-	County: Sedgwick	NW ¼ NE	1/4 SE 1/4 SE		N - *4* ·	T 27 S	1 PE TW	
	Street/Rural Address of Well Location; if unknown, distance & direction from nearest town or intersection: If at owner's address, check here Former Coastal Refinery, 2461 N. New York Street, Wichita, Ks.				Global Positioning Systems (GPS) information:  Latitude: 37.72535637 (in decimal degrees)  Longitude: -97.31932679 (in decimal degrees)  Elevation: 1313.07  Horizontal Datum: WGS84, NAD83, NAD22			
					on Method:	☐ WGS84,	NAD83, NAD2	
2	WATER WELL OWNER: El Paso, LLC RR#, St. Address, Box #: 1515 Des Peres Road, Suite 300 City, State ZIP Code: St. Louis, MO. 63131					ke/Model:		
						noto, Topographic M		
					racy: $\square$ <	3 m	5.15 m	
Jan, 3 13 III,							3-13 m, = > 13 m	
3	WITH AN "X" IN SECTION 4 DEFIN OF WELL 23.09 It.							
	BOX: WELL'S STATIC WATER LEVEL 16.					ft		
	WELL WAS USED AS:							
	NW NE NE	□ Dom	estic	Public	Water Supp	ly Devet	terina	
,,,	Irrigation Oil Field Water Supply Monitoring							
W	W Feedlot Domestic (Lawn & Garden) Injection Well							
	SW SE Industrial Air Conditioning Other recovery							
	Was a chemical/bacteriological sample submitted to Department? Yes No							
S								
5 TYPE OF BLANK CASING USED:								
Steel RMP (SR) Wrought Fiberglass Other (Specify below)								
	PVC ABS Asbestos-Cement Concrete Tile							
Blank casing diameter 14 in. Was casing pulled? Yes No If yes, how much 17 ft.								
Casing height above or below land surface 30 in.								
6 GROUT PLUG MATERIAL: $\square$ Neat cement $\square$ Cement grout $\square$ Bentonite $\square$ Other								
	Grout Plug Intervals: From 0 ft. to 25.89 ft., From ft. to ft., From ft., From ft. to ft.							
What is the nearest source of possible contamination:								
Septic tank Seepage pit Fuel storage Other (specify below)								
	Sewer lines Pit privy Fertilizer storage contaminated site							
		wage lagoon	Insect	cide storage				
	Lateral lines Cess pool  Cess pool  Cess pool  Cess pool  Cess pool  Abandoned water well Oil well/Gas well  Direction from well?  NA  How many feet? 0							
	TDOM:	*						
	0 05 00	GING MATE	RIALS	FROM	ТО	PLUGGING N	MATERIALS	
	0 25.89 Bentonite	<del></del>	····			· · · · · · · · · · · · · · · · · · ·		
			<del></del>	**				
		<del></del>				· · · · · · · · · · · · · · · · · · ·		
		<u></u>						
7 CONTRACTOR'S OR LANDOWNER'S CERTIFICATION: This water well was plugged under my jurisdiction and was								
and this record is true to the best of my knowledge and belief. Konses Water								
well Contractor's License No. 604 This Water Well Record was completed on (mo/day/year) 12/1/2020 under the								
business name of Environmental Priority Service, Inc. by (signature) by (signature)								
Send one white copy to Kansas Department of Health & Environment, Geology Section, 1000 SW Jackson Street, Ste. 420, Topeka, KS								
60612-1367. Send one copy to WATER WELL OWNER and retain one for your records								
Visit us at <a href="http://www.kdheks.gov/waterwell/index.html">http://www.kdheks.gov/waterwell/index.html</a> Telephone 785-296-5524.								

KSA82a-1212

Revised 1/20/2015

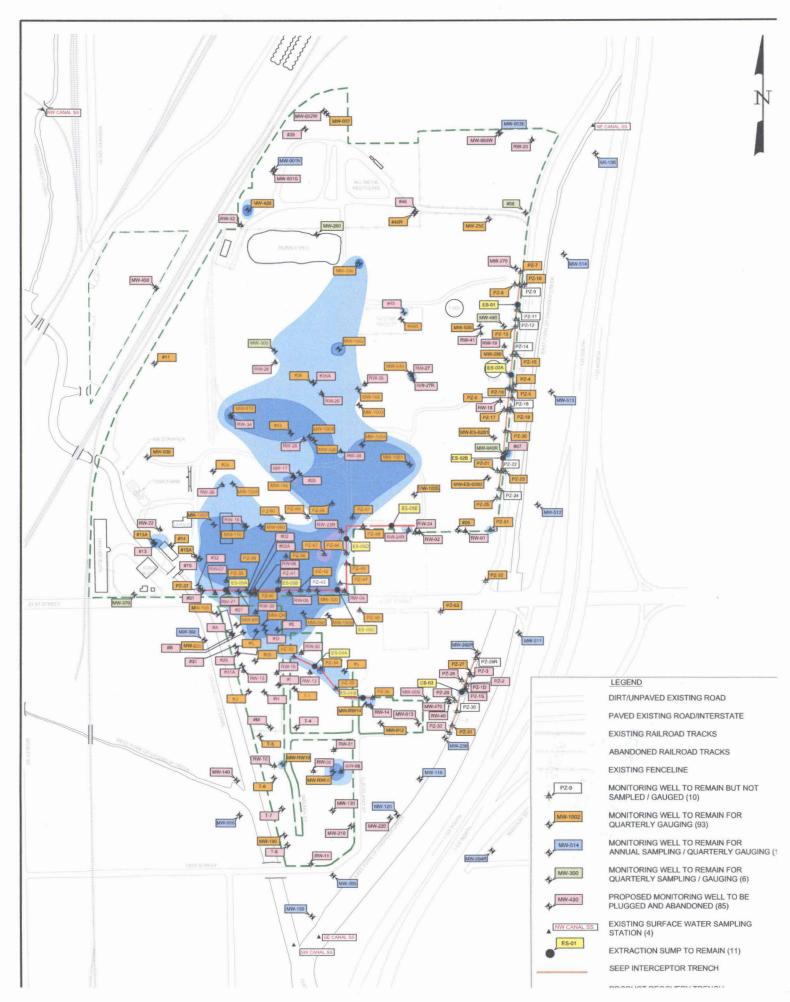

T27 R1E Sec 4 T27 R1E Sec 9

