
W	ATER WELL PLUGGING	RECORD	Form WV	VC-5P	KSA 82	2a-1212 ID 1	NO.	RW-19				
1	LOCATION OF WATER WELL:	Fraction		Section	Number	Township Nu		Range N	umber			
<u> </u>	County: Sedgwick	NW 1/4 NE	1/4 SE 1/4 SE			T 27	S	1	Ø E □W			
	direction from person town as interesting	Street/Rural Address of Well Location; if unknown, distance & direction from nearest town or intersection: If at owner's address,					Global Positioning Systems (GPS) information:					
	check here Former Coastal R		Latitude: 37.72610668 (in decimal degrees) Longitude: -97.3192443 (in decimal degrees)									
	Street, Wichita, K	Elevation	Elevation: 1313.76									
					ıl Datum:	☐ WGS84,		NAD83,	□ NAD2			
			n Method:									
2	WATER WELL OWNER: EI Pa	aso, LLC		GP	S unit (Mal							
	RR#, St. Address, Box #: 1515 D	Dig	gital Map/Ph	oto, 🔲 Topogra	phic Ma	ap, LL	and Survey					
	City, State ZIP Code: St. Louis,		Est. Accuracy: \square < 3 m, \square 3-5 m, \square 5-15 m, \square > 15 m									
3 MARK WELL'S LOCATION WITH AN "X" IN SECTION 4 DEPTH OF WELL 26.94 ft.												
	BOX: WELL'S STATIC WATER LEVEL 17.66											
	N	N WELL WAS USED AS:										
	NW I I I											
	Domestic Public Water Supply Dewatering											
W	Irrigation Oil Field Water Supply Monitoring Domestic (Lawn & Garden) Injection Well											
	Industrial A. C. Itilian de Guiden)											
	SE X			- All Con	umoning		Omer <u>r</u>	ecovery				
		Was a ch	emical/bacteri	ological sam	ple submit	ted to Departmen	nt? Yes	s \square N	0			
5	S											
TITE OF BLAIR CASING USED:												
Steel RMP (SR) Wrought Fiberglass Other (Specify below)												
	PVC ABS Wrought Fiberglass Other (Specify below) Concrete Tile											
	Blank casing diameter 14 in. Was casing pulled? Yes No If yes, how much 17 ft.											
Casing height above or below land surface 30 in.												
6 GROUT PLUG MATERIAL: Neat cement Cement grout Bentonite Other												
	Grout Plus Internal P. O. o. O. O.											
	Grout Plug Intervals: From 0 ft. to 26.94 ft., From ft. to ft., From ft., From ft. to ft.											
What is the nearest source of possible contamination:												
		epage pit	Fuel st	orage		ther (enecify hal	larri)					
	Sewer lines Pit	privy		zer storage		other (specify bel contaminated si						
		wage lagoon	Insecti	cide storage	***	ortarrinated 3	10					
		edyard		oned water w	vell Dire	ection from well?	NA					
	Cess pool Liv	vestock pens	Oil wel	l/Gas well	Hov	many feet? 0						
	FROM TO PLUG	GING MATEI	DIATO	EDOM I								
	0 2004	JING MATE	CIALS	FROM	TO	PLUGG	ING M	ATERIAI	LS			
	0 26.94 Bentonite											

ļ												
ļ												
[
7 CONTRACTOR'S OR LANDOWNER'S CERTIFICATION: This water well was plugged under my jurisdiction and was												
and this record is true to the best of my knowledge and helief Kansas Water												
This Water Well Record was completed on (mo/day/year) 12/7/2020 under the												
ousir	ess name or Environmental Priorit	y Service, In	C	by (sig	nature)	thout						
Sen	d one white conv to Kansas Departm	ent of Health	& Environment	+ Ga-1 G	100							
	d one white copy to Kansas Department of the copy to the copy to the copy of the copy to the copy of the copy to the copy of the	d one conv to	× Environmen WATER WEI	i, Geology S	ection, 100	U SW Jackson S	treet, S	te. 420, T	opeka, KS			
66612-1367. Send one copy to WATER WELL OWNER and retain one for your records. Visit us at http://www.kdheks.gov/waterwell/index.html Telephone 785-296-5524.												

KSA82a-1212

Revised 1/20/2015

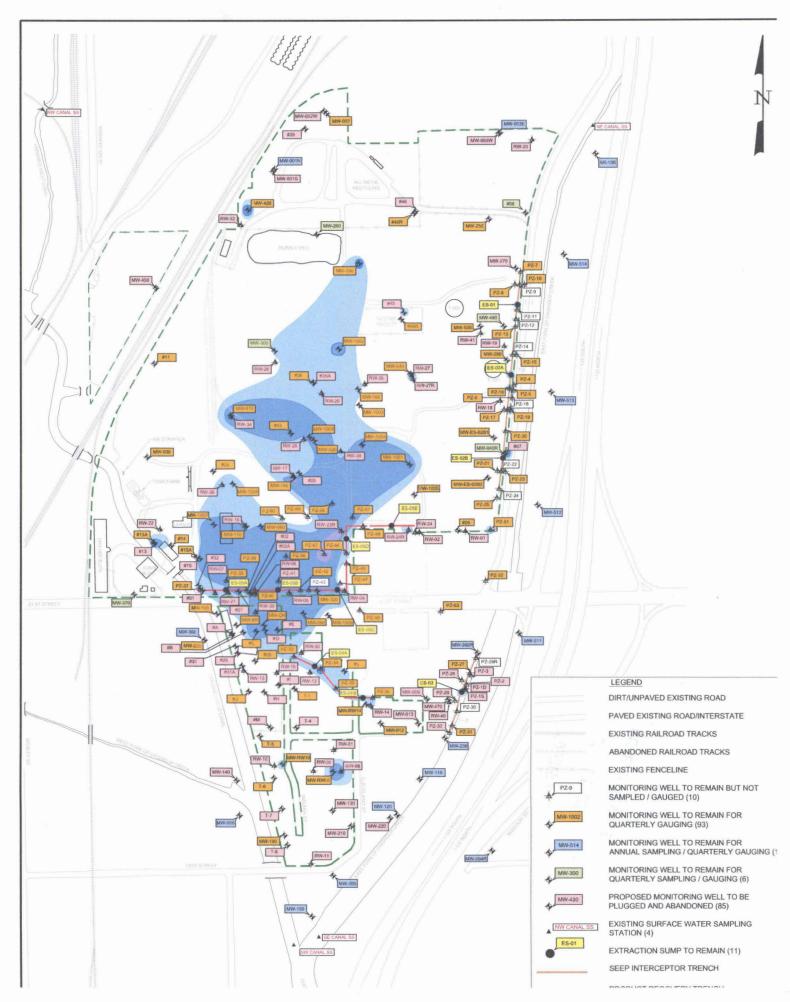

T27 R1E Sec 4 T27 R1E Sec 9

