

WATER WELL PLUGGING RECORD Form WWC-5P

KSA 82a-1212

ID NO.

RW-35

1 LOCATION OF WATER WELL: Fraction NW 1/4 NW 1/4 SE 1/4 SE 1/4 Section Number 4 Township Number T 27 S Range Number 1 ☒ E ☐ W
County: Sedgwick

Street/Rural Address of Well Location; if unknown, distance & direction from nearest town or intersection: If at owner's address, check here ☐ Former Coastal Refinery, 2461 N. New York Street, Wichita, Ks.

Global Positioning Systems (GPS) information:

Latitude: 37.72561003 (in decimal degrees)

Longitude: -97.32164414 (in decimal degrees)

Elevation: 1313.10

Horizontal Datum: ☐ WGS84, ☒ NAD83, ☐ NAD27

Collection Method:


2 WATER WELL OWNER: El Paso, LLC
RR#, St. Address, Box #: 1515 Des Peres Road, Suite 300
City, State ZIP Code: St. Louis, MO. 63131

☐ GPS unit (Make/Model: _____)

☒ Digital Map/Photo, ☐ Topographic Map, ☐ Land Survey

Est. Accuracy: ☐ < 3 m, ☐ 3-5 m, ☐ 5-15 m, ☐ > 15 m

3 MARK WELL'S LOCATION WITH AN "X" IN SECTION BOX:

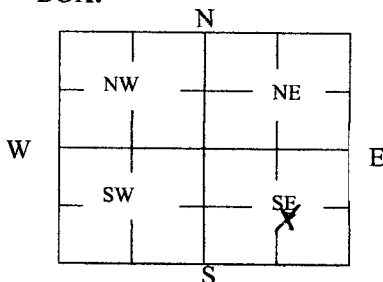

4 DEPTH OF WELL 34.35 ft.

WELL'S STATIC WATER LEVEL 15.41 ft

WELL WAS USED AS:

☐ Domestic
☐ Irrigation
☐ Feedlot
☐ Industrial

☐ Public Water Supply
☐ Oil Field Water Supply
☐ Domestic (Lawn & Garden)
☐ Air Conditioning

☐ Dewatering
☒ Monitoring
☐ Injection Well
☒ Other recovery

Was a chemical/bacteriological sample submitted to Department? Yes ☐ No ☒

5 TYPE OF BLANK CASING USED:

☒ Steel ☐ RMP (SR) ☐ Wrought ☐ Fiberglass ☐ Other (Specify below)
☐ PVC ☐ ABS ☐ Asbestos-Cement ☐ Concrete Tile

Blank casing diameter 14 in. Was casing pulled? Yes ☒ No ☐ If yes, how much 8 ft.

Casing height above or below land surface 30 in.

6 GROUT PLUG MATERIAL: ☐ Neat cement ☐ Cement grout ☒ Bentonite ☐ Other _____

Grout Plug Intervals: From 0 ft. to 34.35 ft., From _____ ft. to _____ ft., From _____ ft. to _____ ft.

What is the nearest source of possible contamination:

☐ Septic tank ☐ Seepage pit ☒ Fuel storage
☐ Sewer lines ☐ Pit privy ☐ Fertilizer storage
☐ Watertight sewer lines ☐ Sewage lagoon ☐ Insecticide storage
☐ Lateral lines ☐ Feedyard ☐ Abandoned water well
☐ Cess pool ☐ Livestock pens ☐ Oil well/Gas well

☒ Other (specify below)
contaminated site

Direction from well? NA
How many feet? 0

FROM	TO	PLUGGING MATERIALS	FROM	TO	PLUGGING MATERIALS
0	34.35	Bentonite			

7 CONTRACTOR'S OR LANDOWNER'S CERTIFICATION: This water well was plugged under my jurisdiction and was completed on (mo/day/year) 10-14-2020 and this record is true to the best of my knowledge and belief. Kansas Water Well Contractor's License No. 604. This Water Well Record was completed on (mo/day/year) 12/7/2020 under the business name of Environmental Priority Service, Inc. by (signature) TA nt

Send one white copy to Kansas Department of Health & Environment, Geology Section, 1000 SW Jackson Street, Ste. 420, Topeka, KS 66612-1367. Send one copy to WATER WELL OWNER and retain one for your records.
Visit us at <http://www.kdheks.gov/waterwell/index.html> Telephone 785-296-5524.

KSA82a-1212

Revised 1/20/2015

