

WATER WELL RECORD Form WWC-5

☐ Original Record ☐ Correction ☐ Change in Well Use

Division of Water
Resources App. No.

Well ID

[illegible]

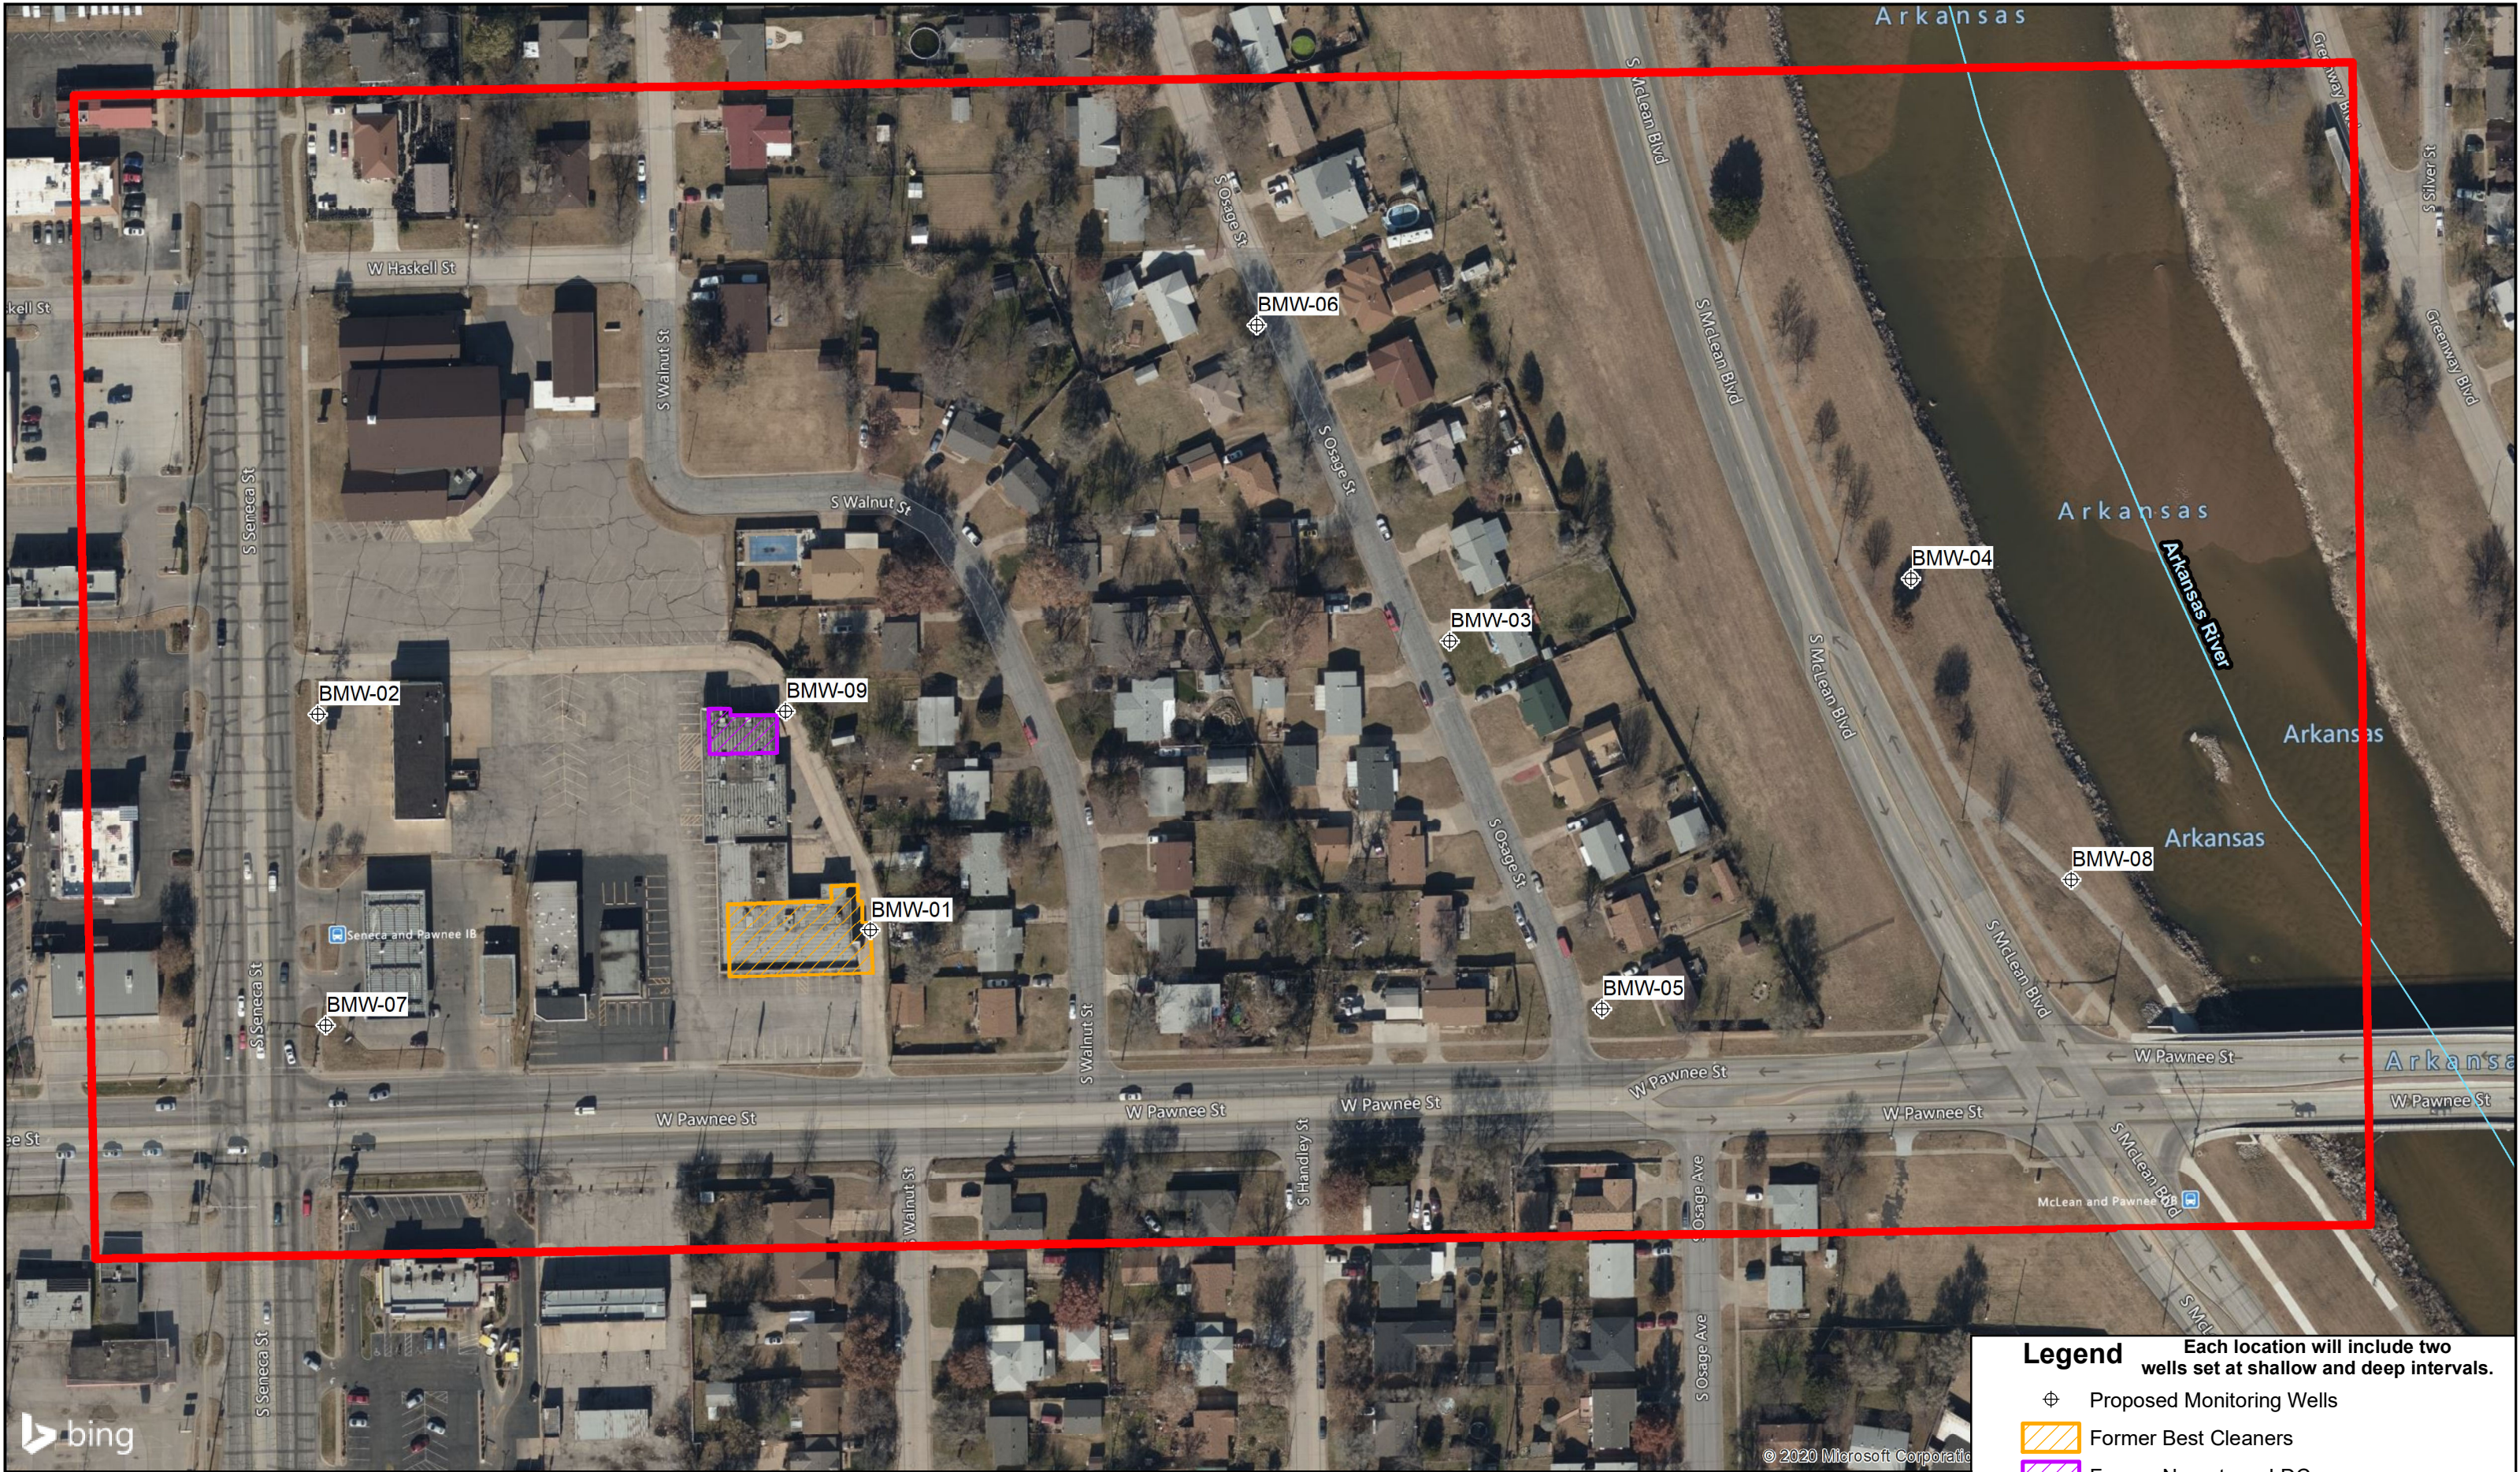


	FIGURE: 2.0	FIGURE NAME: Proposed Monitoring Wells Locations	Best Cleaners-Pawnee Wichita, KS KDHE#: C2-087-73035	<div>0 60 120</div> <div>Feet</div> <div></div>	Legend Each location will include two wells set at shallow and deep intervals. <div>⊕ Proposed Monitoring Wells</div> <div> Former Best Cleaners</div> <div> Former Norgetown LDC</div> <div> Site Study Area</div> <div> Kansas Hydrology FlowLines</div> ALL BOUNDARIES AND LOCATIONS ARE APPROXIMATE	
	DATE: 01/04/2021	PROJECT NUMBER: 2074106				
	DRAWN BY: PM	PROJECT MANAGER: M.Balleau				