

WATER WELL RECORD Form WWC-5

Division of Water Resources App. No.

Well ID MW-971B

- Original Record Correction Change in Well Use

1 LOCATION OF WATER WELL: County: Sedgwick Fraction 1/4 SW 1/4 NW 1/4 NW 1/4 Section Number 33 Township Number T 27 S Range Number R 1 E W

2 WELL OWNER: Last Name: City of Wichita/Environmental Health Business: City of Wichita/Environmental Health Address: 455 N. Main Street or Rural Address where well is located: 1755 S. Topeka Ave. Wichita, KS. well located on the SW corner of the property.

3 LOCATE WELL WITH "X" IN SECTION BOX: N W E S

4 DEPTH OF COMPLETED WELL: 24 ft. Depth(s) Groundwater Encountered: 1) 18 ft. 2) ft. 3) ft. or 4) Dry Well WELL'S STATIC WATER LEVEL: 18.05 ft. below land surface, measured on (mo-day-yr) 12-2-20.

5 Latitude: 37.66076 Longitude: 97.33485 Horizontal Datum: WGS 84 Source for Latitude/Longitude: GPS (unit make/model: Garmin c60)

7 WELL WATER TO BE USED AS: 1. Domestic: Household, Lawn & Garden, Livestock 2. Irrigation 3. Feedlot 4. Industrial 5. Public Water Supply 6. Dewatering 7. Aquifer Recharge 8. Monitoring: well ID MW-971B 9. Environmental Remediation 10. Oil Field Water Supply 11. Test Hole 12. Geothermal 13. Other

Was a chemical/bacteriological sample submitted to KDHE? No If yes, date sample was submitted: Water well disinfected? No

8 TYPE OF CASING USED: Steel PVC Other CASING JOINTS: Glued Clamped Welded Threaded Casing diameter 1.25 in. to 14 ft. Diameter 0.3 in. Weight lbs./ft. Wall thickness or gauge No. Sch. 40

9 GROUT MATERIAL: Neat cement Cement grout Bentonite Other Grout Intervals: From 2 ft. to 10 ft. From 10 ft. to 12 ft. From ft. to ft.

Table with 6 columns: 10 FROM, TO, LITHOLOGIC LOG, FROM, TO, LITHO. LOG (cont.) or PLUGGING INTERVALS. Rows include Sand (0-35) and Weathered Shale (35-).

11 CONTRACTOR'S OR LANDOWNER'S CERTIFICATION: This water well was constructed, reconstructed, or plugged under my jurisdiction and was completed on (mo-day-year) 11/23/2020 and this record is true to the best of my knowledge and belief.

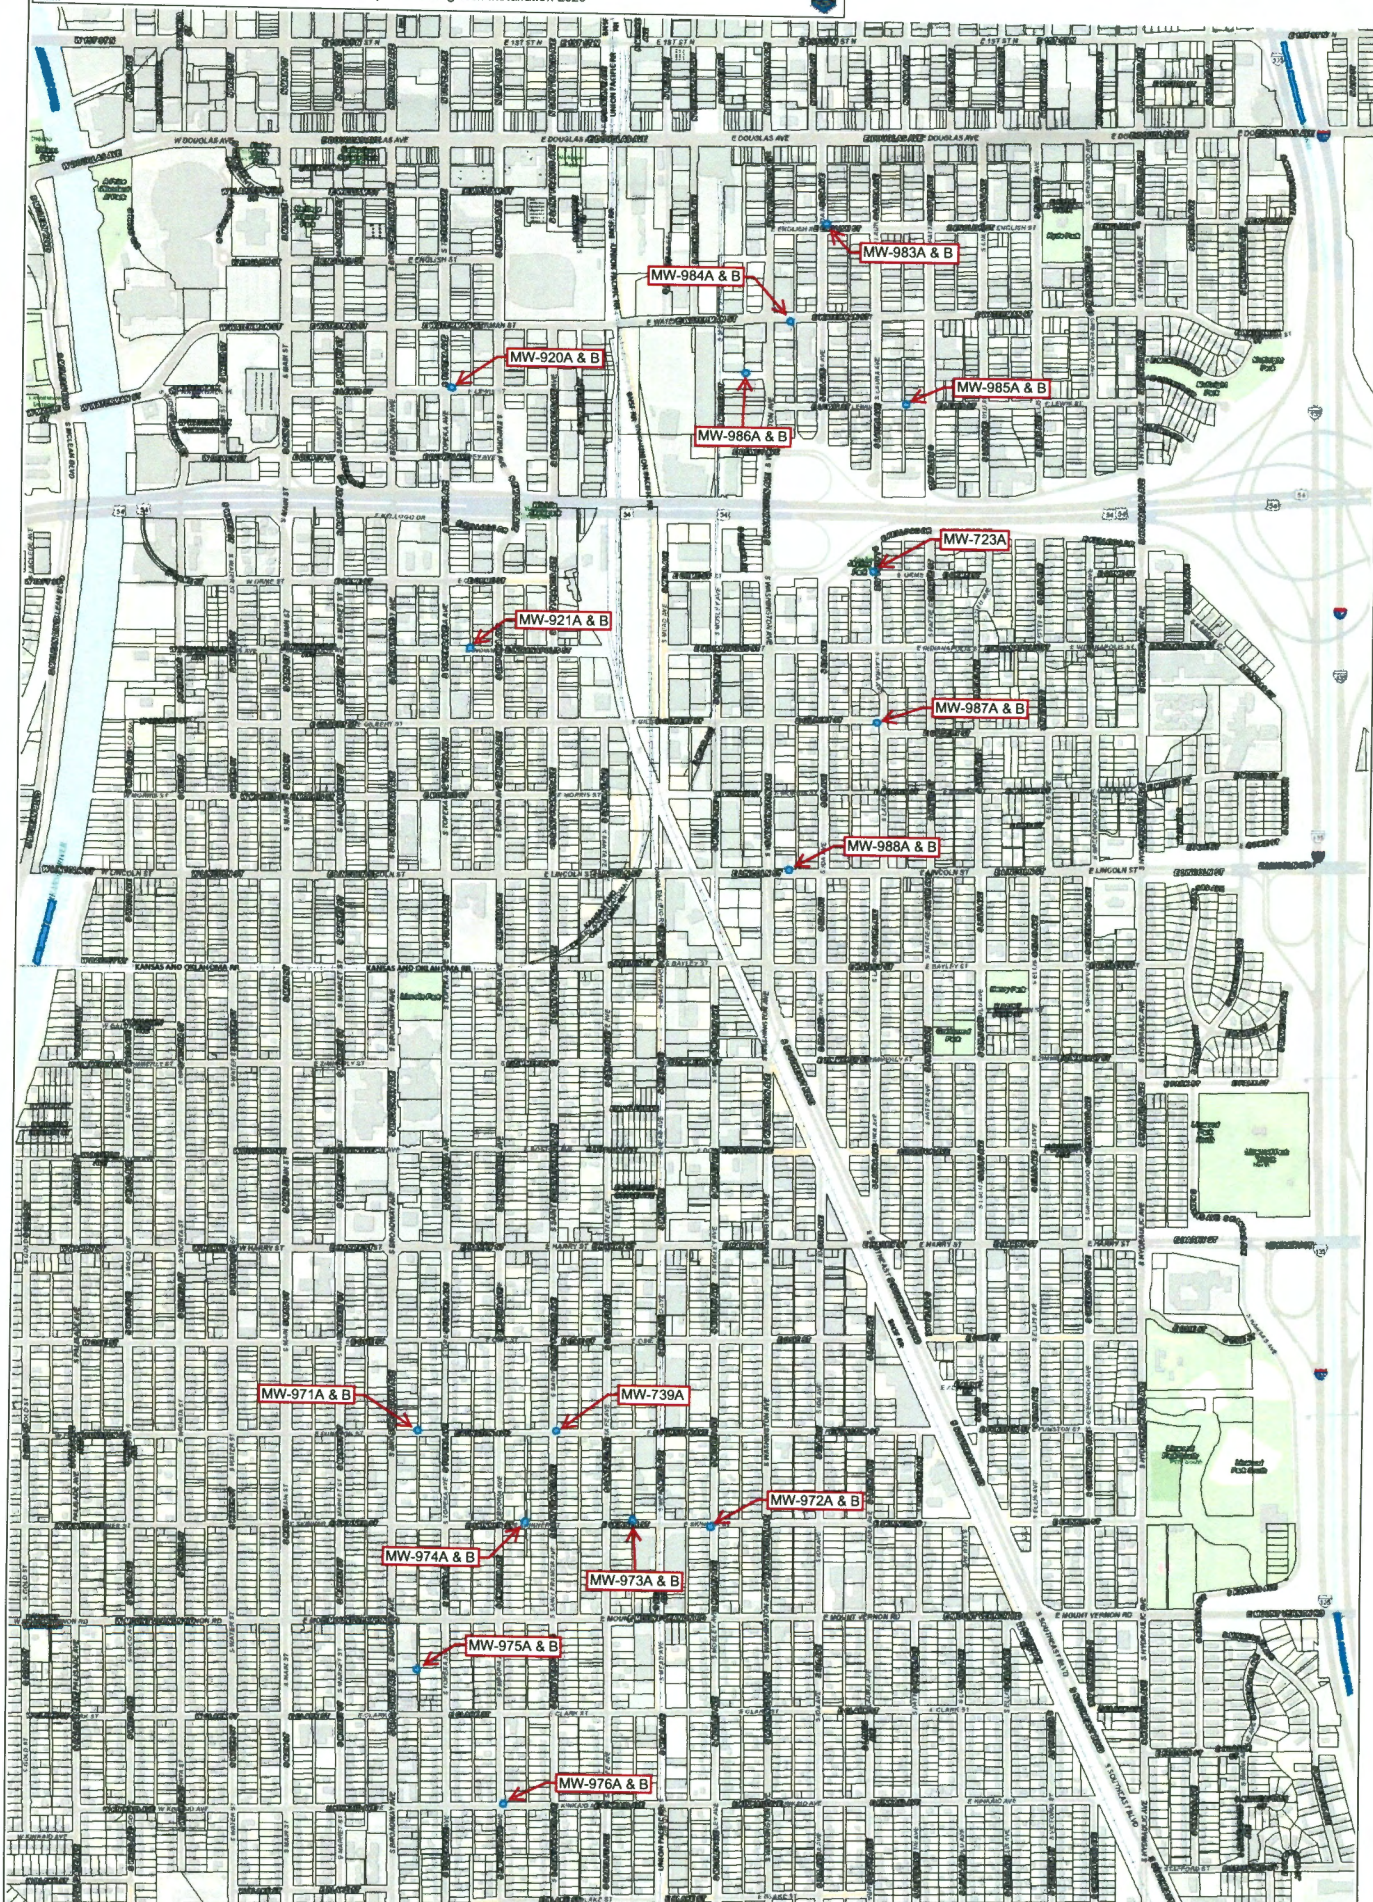


FIGURE-2
Gilbert and Mosley
New Monitoring Wells

Map Created On: 7/15/20 4:03 PM

Parcels
Address Labels
● New Single or Nested Pair Monitoring Well(s) Location

1:4,800
North Arrow
Inset Map