

**WATER WELL RECORD      Form WWC-5**☐ Original Record    ☐ Correction    ☐ Change in Well Use

Division of Water  
Resources App. No.

Well ID

[illegible]

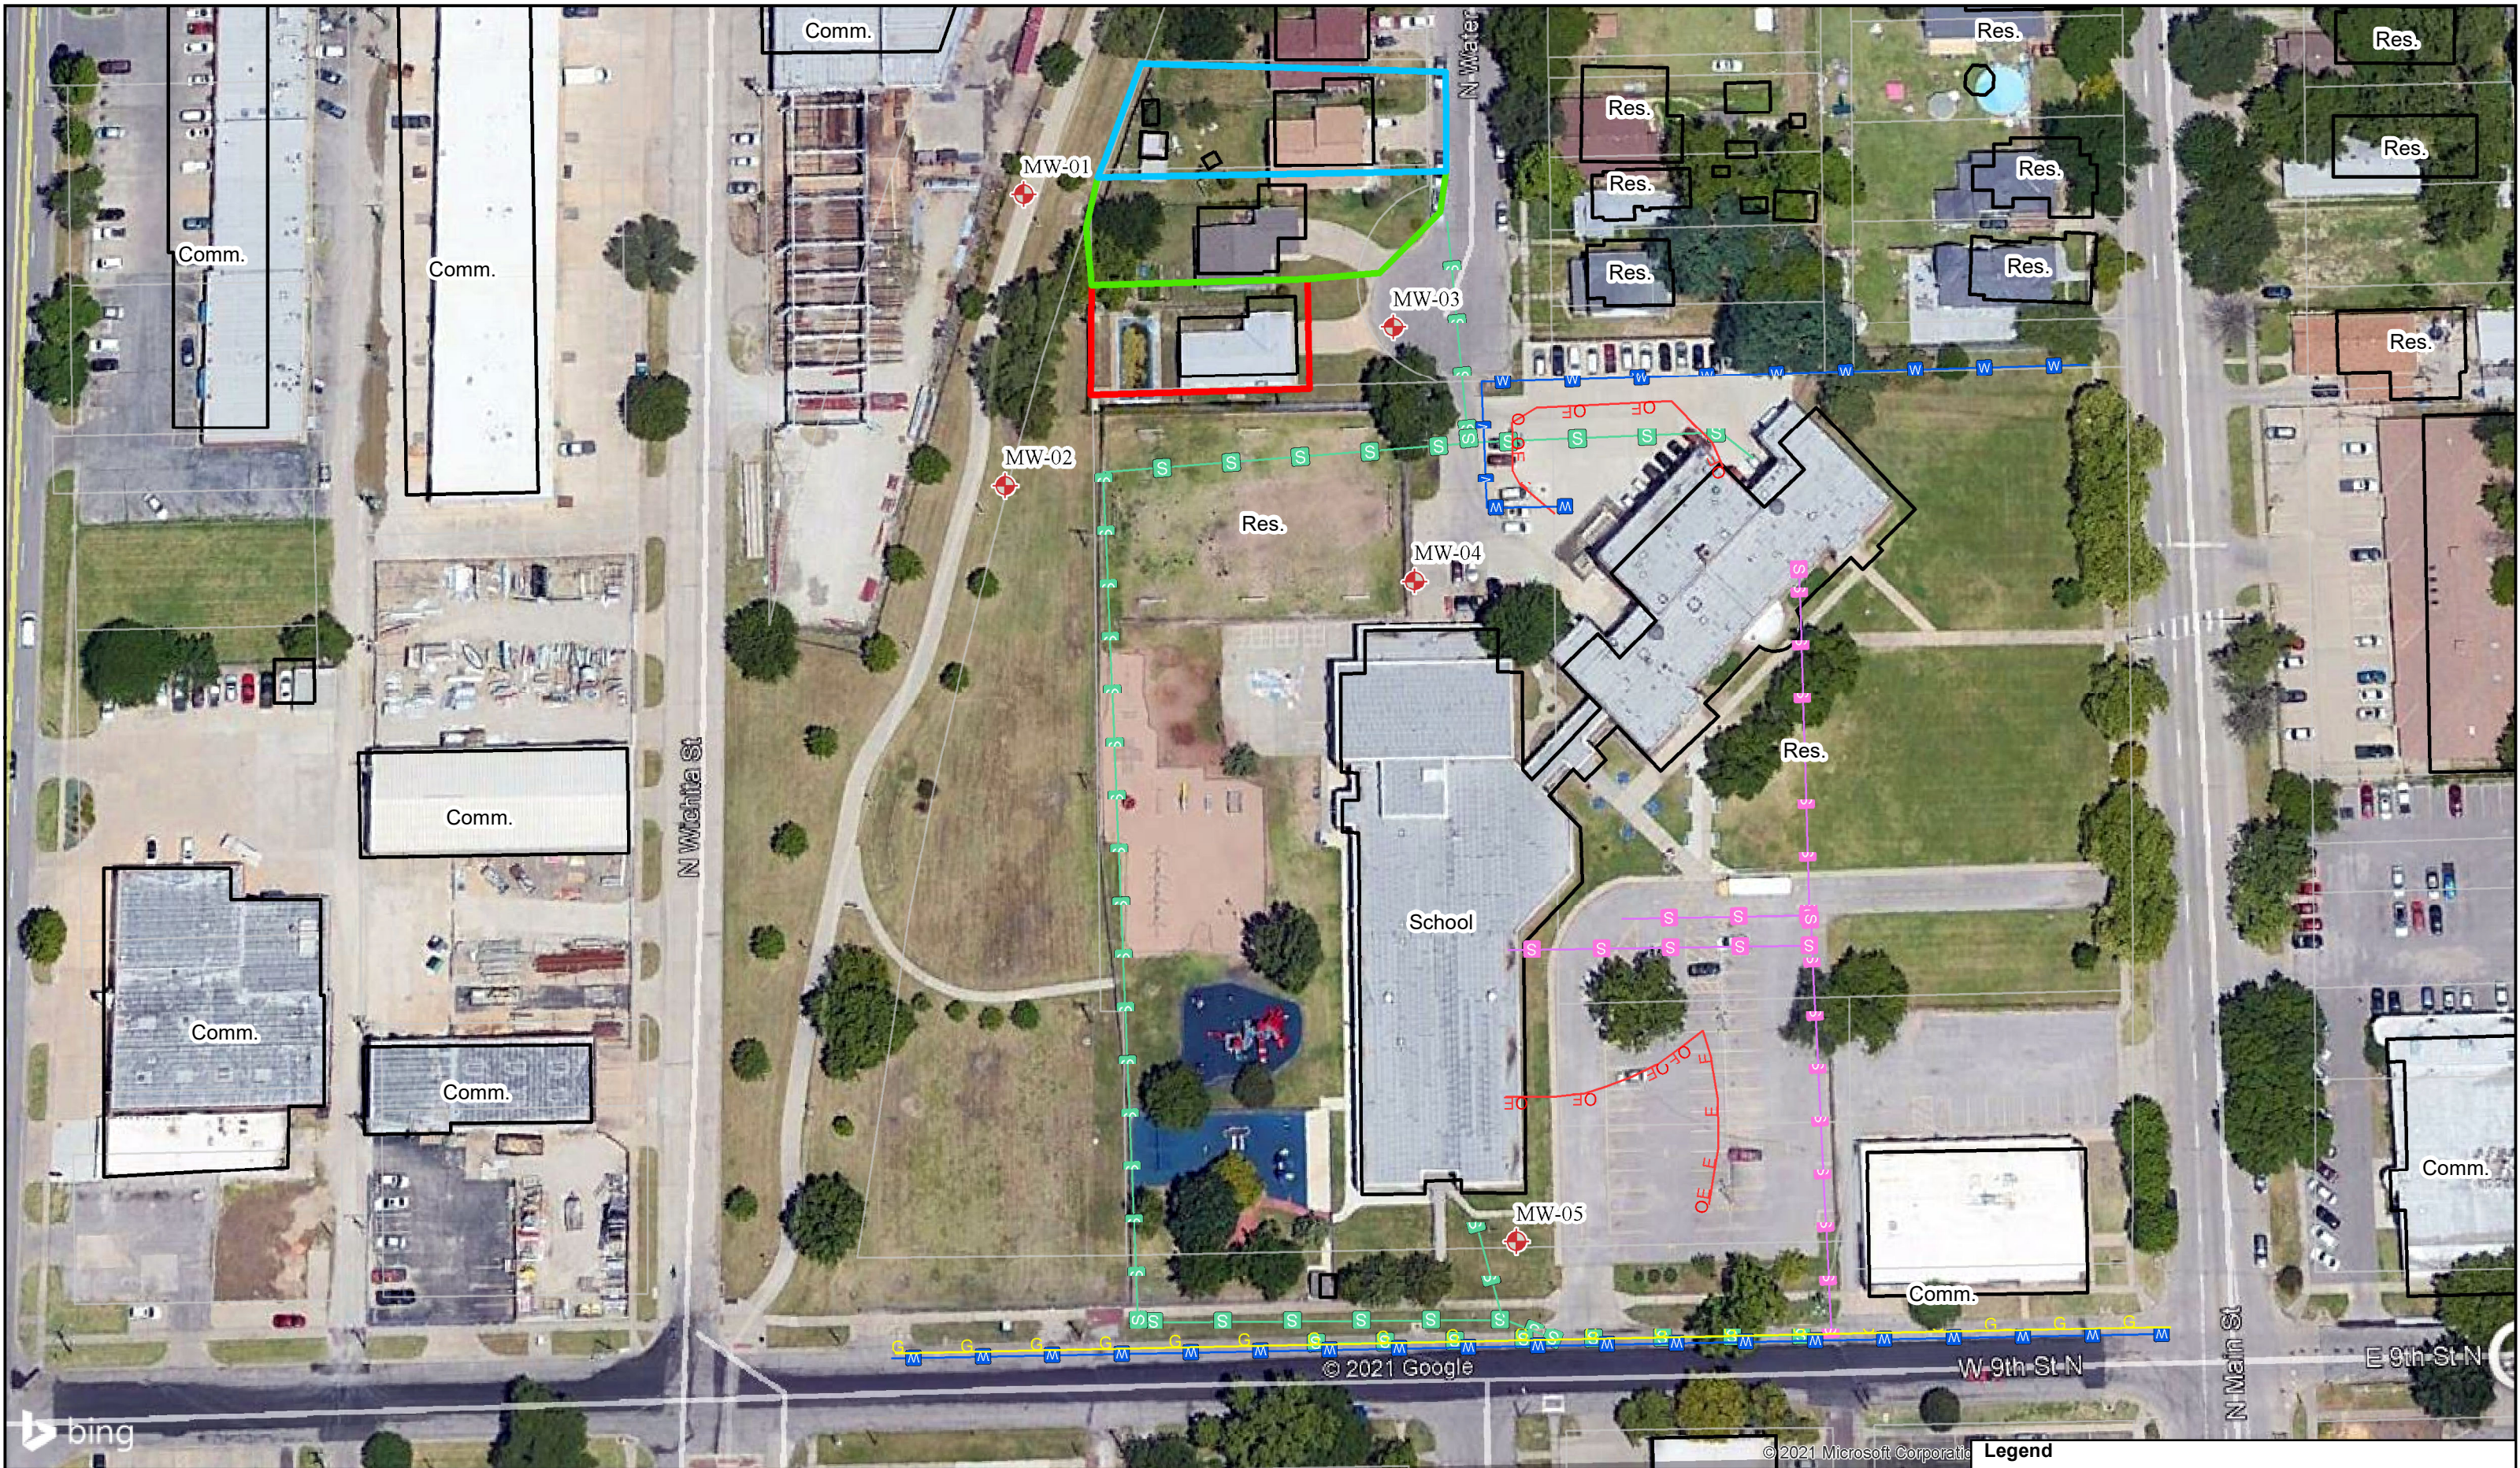


	FIGURE: <b>2.0</b>	FIGURE NAME: <b>Site Base Map With Sample Locations</b>	<b>Wichita Independent Oil Storage</b> <b>N. Water Rd</b> <b>Wichita, KS</b>	<div>Feet 0 75 1 inch = 75 feet</div> <div></div>	<b>Legend</b> <ul style="list-style-type: none"><li> Sample Locations</li><li> F. Taylor Property</li><li> G. Rocha Property</li><li> R&amp;L Arellano Property</li><li> Electric</li><li> Gas</li><li> Sanitary Sewer</li><li> Storm Water Drain</li><li> Water</li><li> Property &amp; Easements</li></ul>	
	DATE: <b>04/30/2021</b>	PROJECT NUMBER: <b>1974150</b>				
	DRAWN BY: <b>CN</b>	PROJECT MANAGER: <b>M. Balleau</b>				