

WATER WELL RECORD Form WWC-5☐ Original Record ☐ Correction ☐ Change in Well Use

Division of Water
Resources App. No.

Well ID

[illegible]

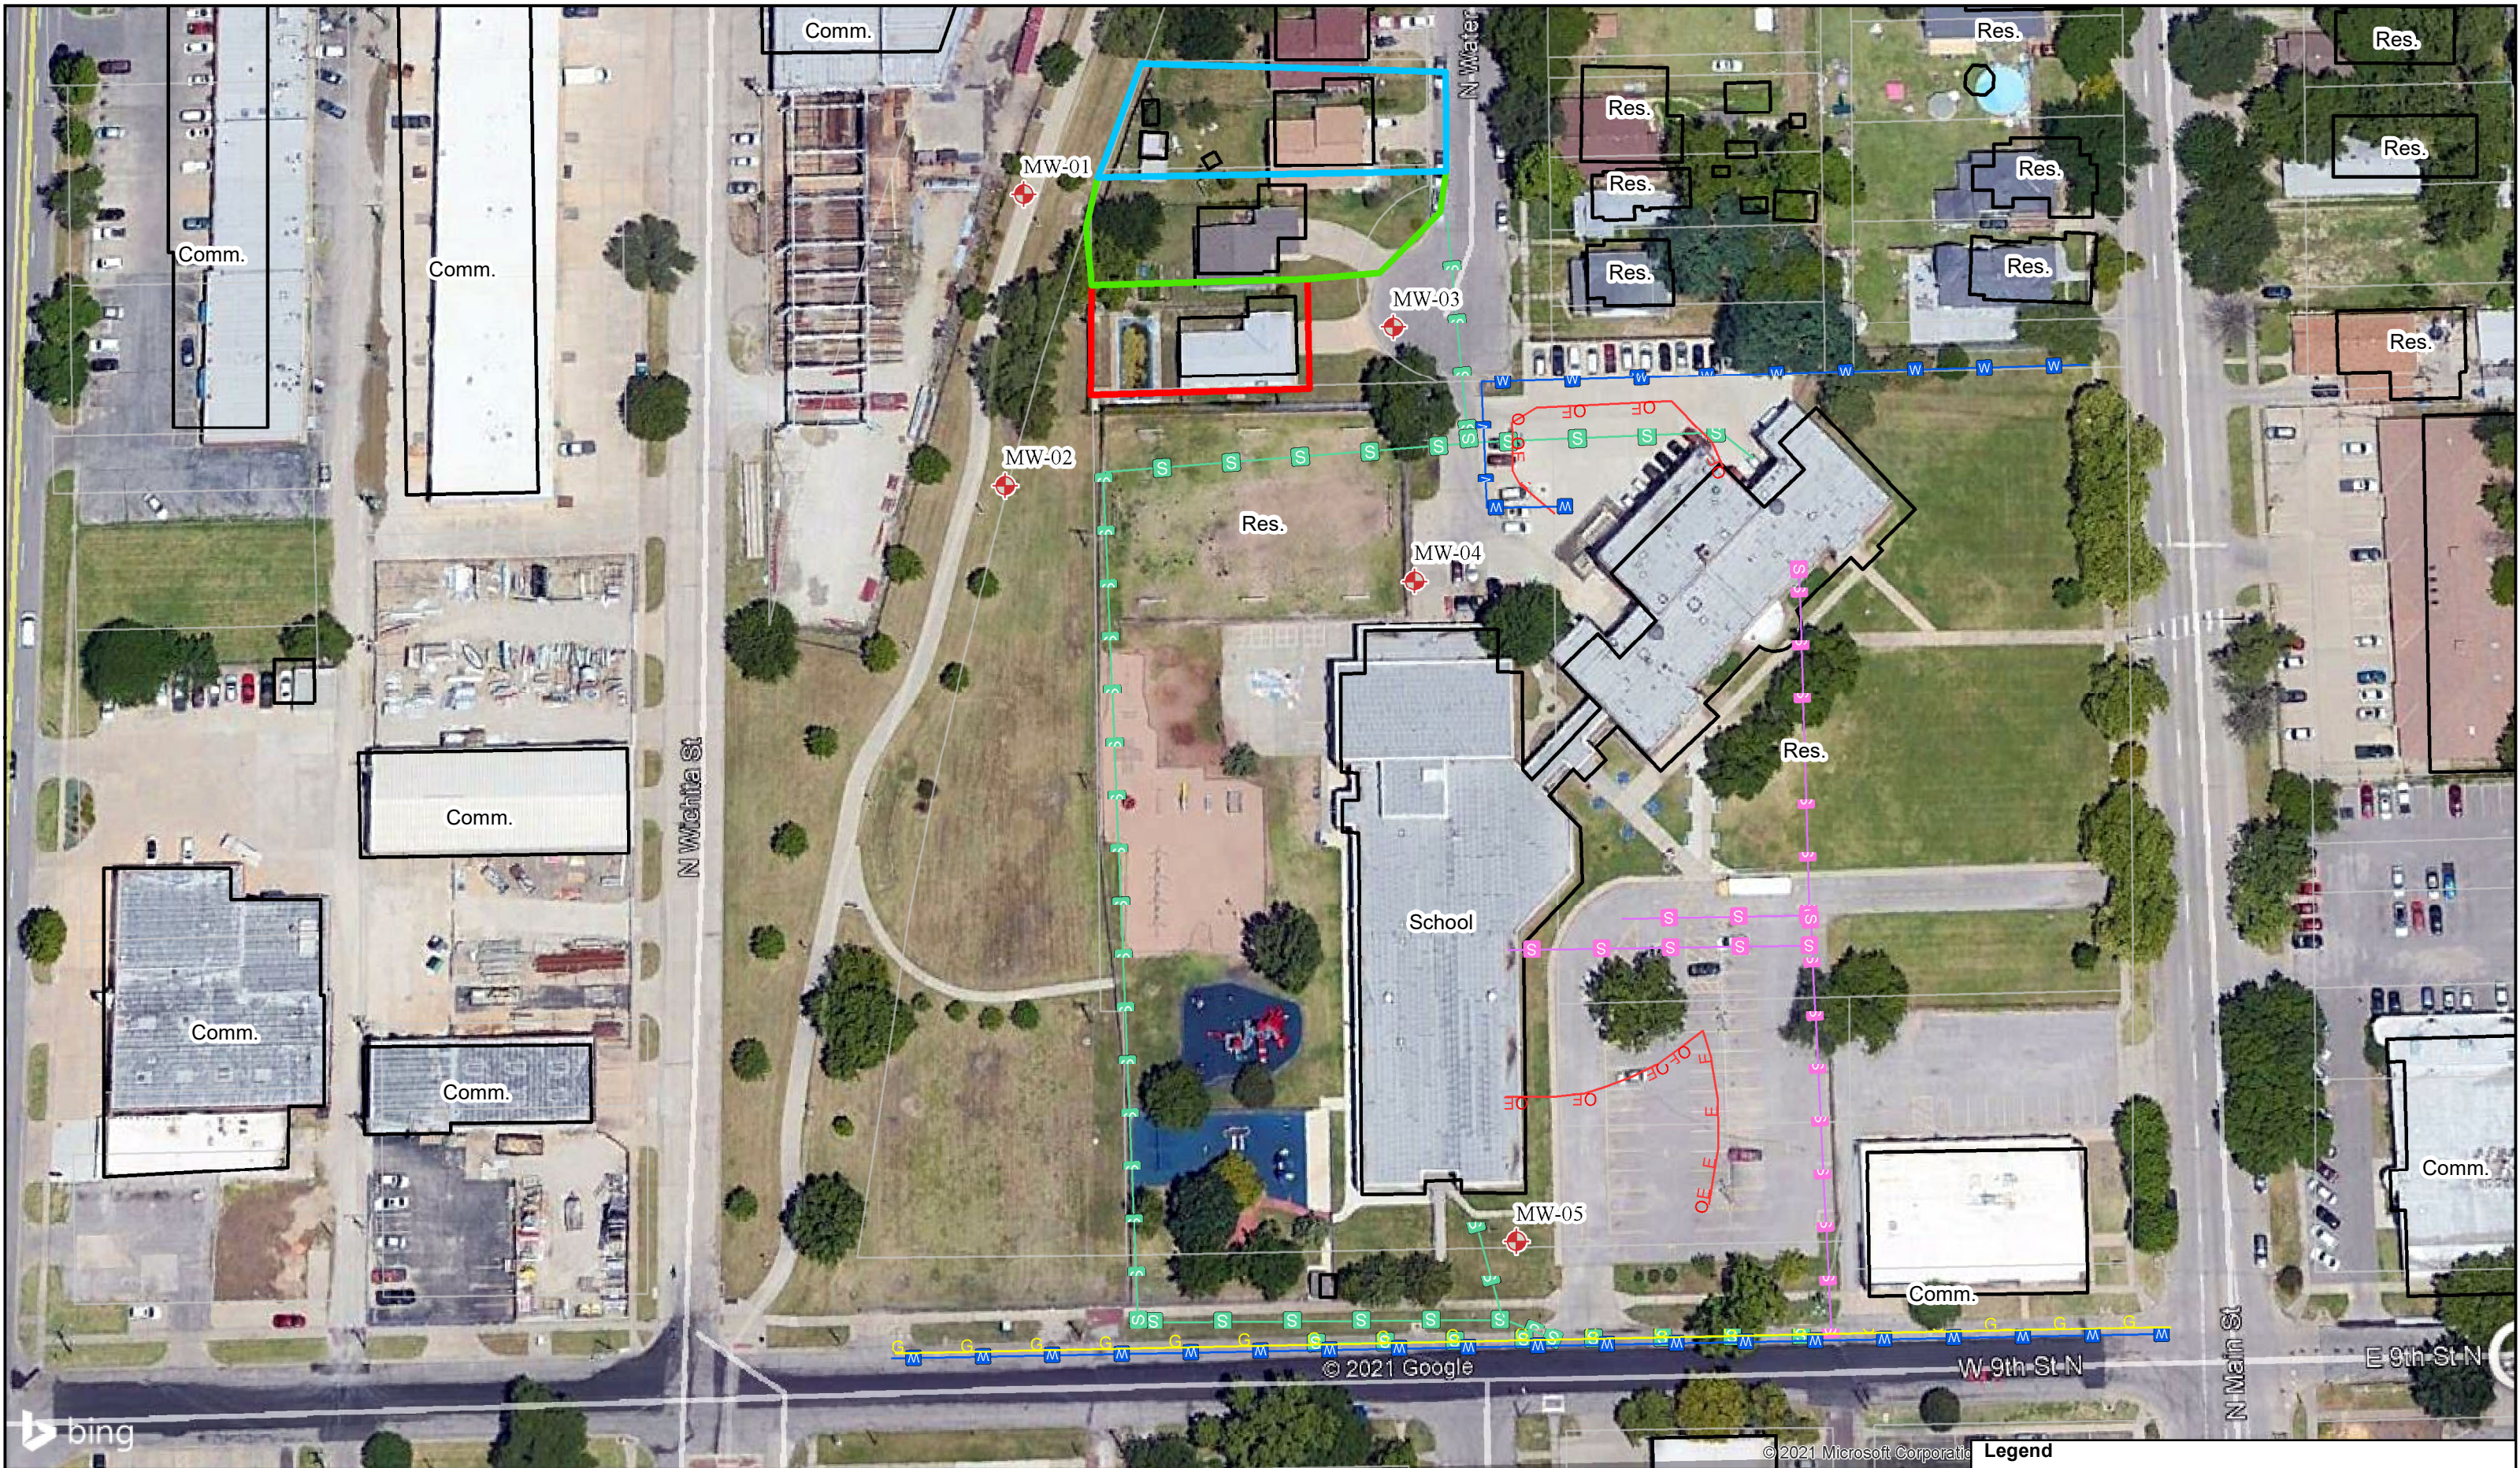


	FIGURE:	2.0	FIGURE NAME:	Site Base Map With Sample Locations	Wichita Independent Oil Storage N. Water Rd Wichita, KS	<div>Feet</div> <div>075</div> <div>1 inch = 75 feet</div> <div></div>	Legend <ul style="list-style-type: none"> Sample Locations F. Taylor Property G. Rocha Property R&L Arellano Property Electric Gas Sanitary Sewer Storm Water Drain Water Property & Easements
	DATE:	04/30/2021	PROJECT NUMBER:	1974150			
	DRAWN BY:	CN	PROJECT MANAGER:	M. Balleau			