


WATER WELL RECORD Form WWC-5

☐ Original Record ☐ Correction ☐ Change in Well Use

Division of Water
Resources App. No.

Well ID

[illegible]

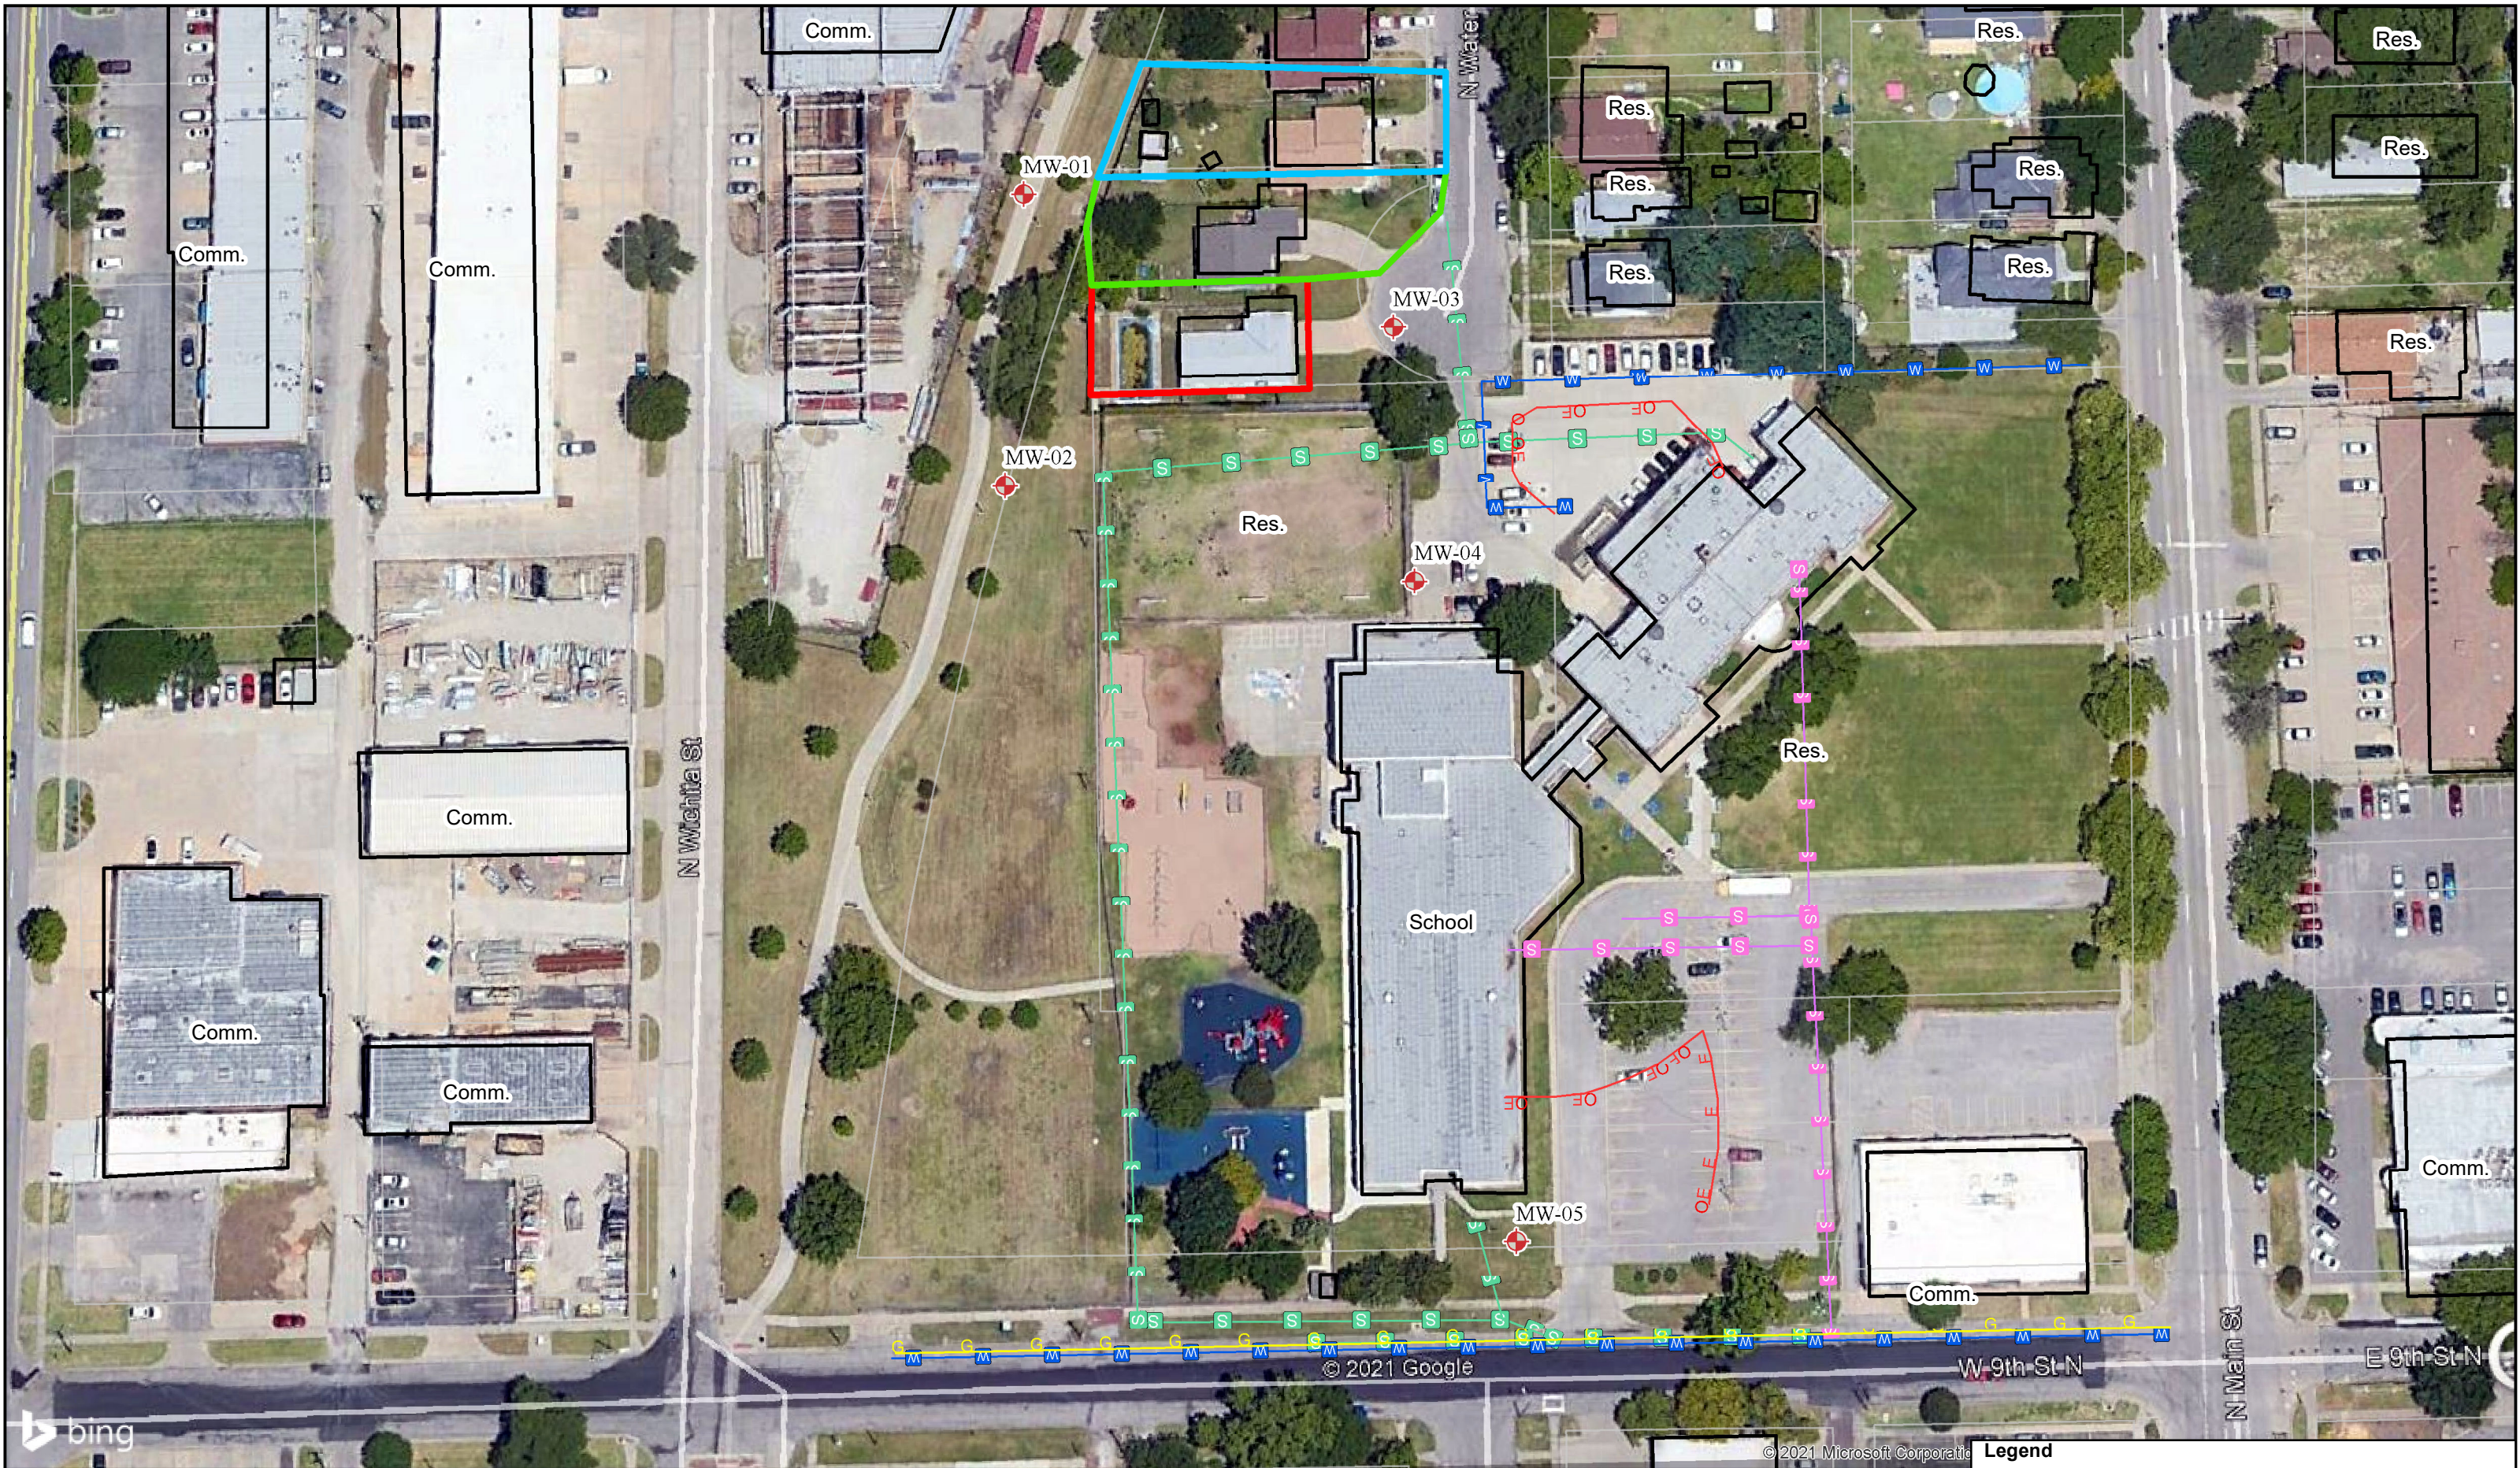

| | | | | | | |
|--|-------------------------|---|--|---|--|--|
| | FIGURE: 2.0 | FIGURE NAME: Site Base Map With Sample Locations | Wichita Independent Oil Storage N. Water Rd Wichita, KS | <div>Feet 0 75 1 inch = 75 feet</div> <div></div> | Legend <ul style="list-style-type: none"> Sample Locations F. Taylor Property G. Rocha Property R&L Arellano Property Electric Gas Sanitary Sewer Storm Water Drain Water Property & Easements | |
| | DATE: 04/30/2021 | PROJECT NUMBER: 1974150 | | | | |
| | DRAWN BY: CN | PROJECT MANAGER: M. Balleau | | | | |