


1 LOCATION OF WATER WELL: County: Sedgwick Fraction: SW 1/4 SE 1/4 NW 1/4 NW 1/4 Section Number: 110 Township Number: T 27 S Range Number: 1 E W

Street/Rural Address of Well Location; if unknown, distance & direction from nearest town or intersection: If at owner's address, check here Northside right-of-way on E. 11th St. just east of N. Emporia Ave., Wichita, KS

Global Positioning Systems (GPS) information:
 Latitude: 37.70446 (in decimal degrees)
 Longitude: 97.33286 (in decimal degrees)
 Elevation: _____
 Datum: WGS84, NAD83, NAD27
 Collection Method:
 GPS unit (Make/Model: Garmin 60C)
 Digital Map/Photo, Topographic Map, Land Survey
 Est. Accuracy: < 3 m, 3-5 m, 5-15 m, > 15 m

2 WATER WELL OWNER: City of Wichita/Env. Hlth
 RR#, St. Address, Box #: 455 N. Main
 City, State ZIP Code: Wichita, KS 67202

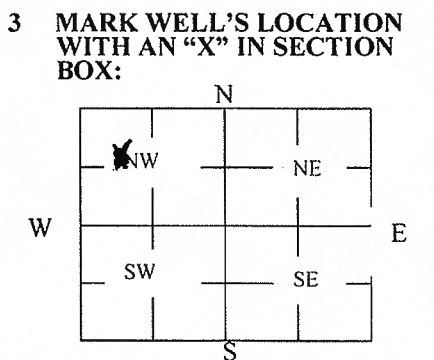

4 DEPTH OF WELL 39.77 ft.
 WELL'S STATIC WATER LEVEL 12 ft.
 WELL WAS USED AS:
 Domestic Public Water Supply Dewatering
 Irrigation Oil Field Water Supply Monitoring
 Feedlot Domestic (Lawn & Garden) Injection Well
 Industrial Air Conditioning Other _____
 Was a chemical/bacteriological sample submitted to Department? Yes No


5 TYPE OF BLANK CASING USED:
 Steel RMP (SR) Wrought Fiberglass Other (Specify below)
 PVC ABS Asbestos-Cement Concrete Tile
 Blank casing diameter 6 in. Was casing pulled? Yes No If yes, how much 4 ft.
 Casing height above or below land surface -0.6 in.

6 GROUT PLUG MATERIAL: Neat cement Cement grout Bentonite Other _____
 Grout Plug Intervals: From 2 ft. to 39.77 ft., From _____ ft. to _____ ft., From _____ to _____ ft.
 What is the nearest source of possible contamination:
 Septic tank Seepage pit Fuel Storage Other (specify below)
 Sewer lines Pit privy Fertilizer storage
 Watertight sewer lines Sewage lagoon Insecticide storage
 Lateral lines Feedyard Abandoned water well Direction from well? _____
 Cess pool Livestock pens Oil well/Gas well How many feet? _____

FROM	TO	PLUGGING MATERIALS	FROM	TO	PLUGGING MATERIALS
0	2	Topsoil - (grass)			
2	39.77	Bentonite			

7 CONTRACTOR'S OR LANDOWNER'S CERTIFICATION: This water well was plugged under my jurisdiction and was completed on (mo/day/year) 2/11/2020 and this record is true to the best of my knowledge and belief. Kansas Water Well Contractor's License No. 710. This Water Well Record was completed on (mo/day/year) 3/10/2020 under the business name of Below Ground Surface, Inc. by (signature) [Signature]

INSTRUCTIONS: Use typewriter or ballpoint pen. Please press firmly and print clearly. Please fill in blanks, underline or circle the correct answers. Send top three copies to Kansas Department of Health and Environment, Bureau of Water, Geology Section, 1000 SW Jackson St., Ste. 420, Topeka, Kansas 66612-1367. Telephone: 785/296-5524. Send one to Water Well Owner and retain one for your records. Visit us at <http://www.kdheks.gov/waterwell/index.html>.

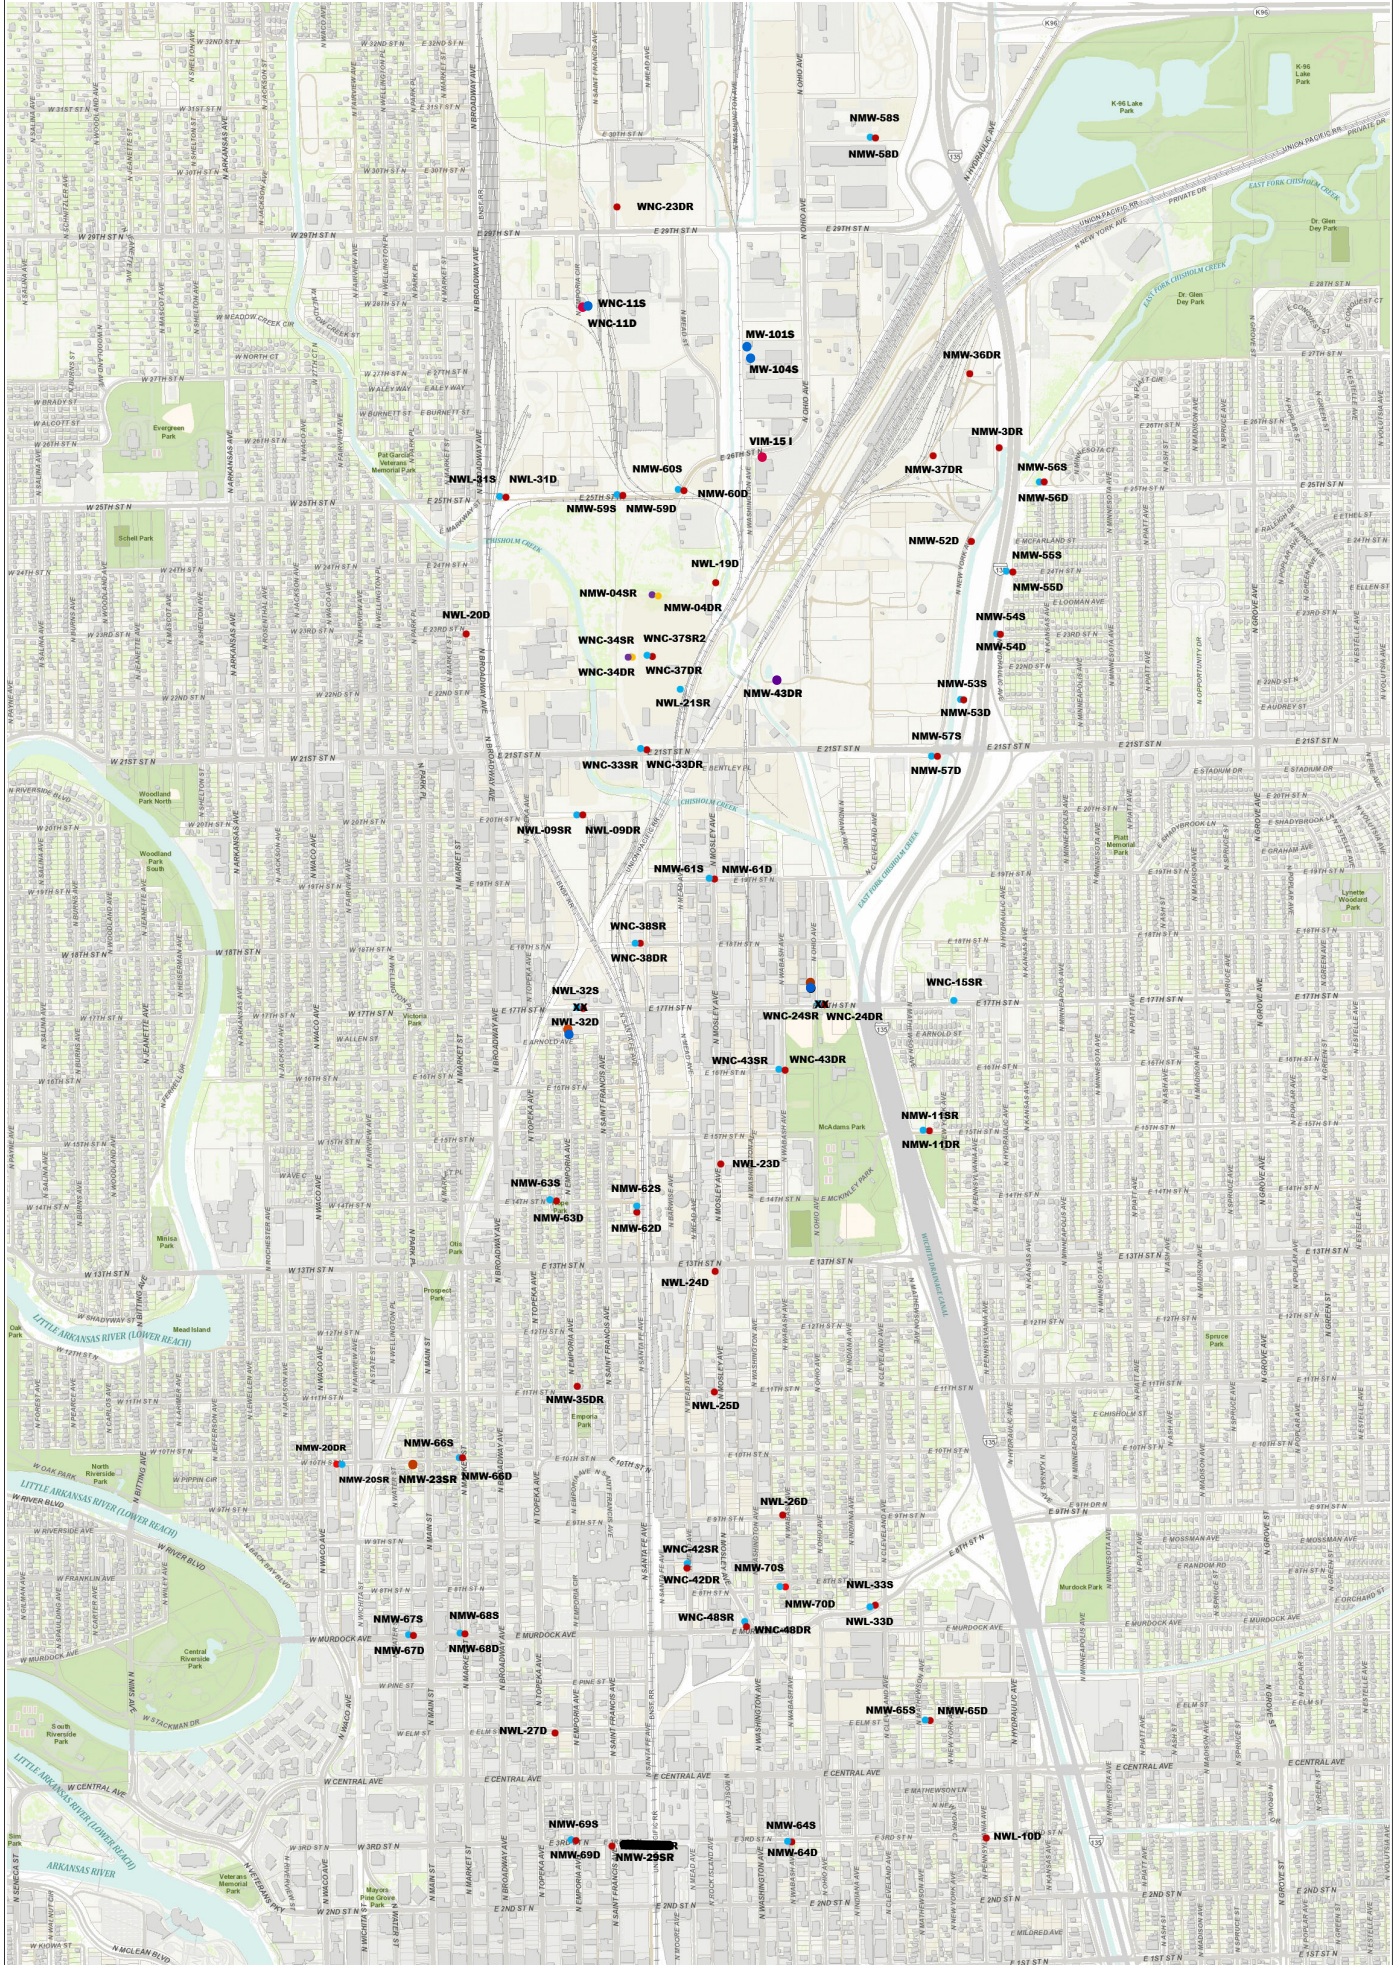

1:2000 0 600.00 1,200.00 Feet
This information is not an official record, and cannot be used as such. The user should rely only upon official records available from the custodian of records in the appropriate City and/or County department. Some data provided here was used for the preparation of these maps has been obtained from public records not created or maintained by the City of Wichita.
Map Created On: 06/19 10:37 AM

- Shallow Monitoring Well with Stickup Surface Completion
- Deep Monitoring Well with Stickup Surface Completion
- Shallow Monitoring Well with Flushmount Surface Completion
- Deep Monitoring Well with Flushmount Surface Completion

1:7,200

