

**WATER WELL RECORD Form WWC-5**

Division of Water Resources App. No.  

Well ID NWL-27D

Original Record  Correction  Change in Well Use

<b>1 LOCATION OF WATER WELL:</b> County: Sedgwick	Fraction <i>NE 1/4 SW 1/4 SW 1/4 SW 1/4</i>	Section Number <i>16</i>	Township Number <i>T 27 S</i>	Range Number <i>R 1 E</i>
--	--	-----------------------------	----------------------------------	------------------------------

**2 WELL OWNER:** Last Name: *City of Wichita/Environmental Health* First:   
 Business: *City of Wichita/Environmental Health*  
 Address: *455 N. Main*  
 Address:   
 City: *Wichita* State: *KS* ZIP: *67202*  
 Street or Rural Address where well is located (if unknown, distance and direction from nearest town or intersection): If at owner's address, check here:   
*Southside right-of-way on E. Elm St. approx 100 feet east of N. Topeka Ave., Wichita, KS*

<p><b>3 LOCATE WELL WITH "X" IN SECTION BOX:</b> N</p> <table border="1" style="width: 100%; text-align: center;"> <tr><td> </td><td> </td><td> </td></tr> <tr><td>-- NW --</td><td>-- NE --</td><td> </td></tr> <tr><td>W</td><td> </td><td>E</td></tr> <tr><td>-- SW --</td><td>-- SE --</td><td> </td></tr> <tr><td> </td><td> </td><td> </td></tr> <tr><td>S</td><td> </td><td> </td></tr> </table> <p>----- 1 mile -----</p>				-- NW --	-- NE --		W		E	-- SW --	-- SE --					S			<p><b>4 DEPTH OF COMPLETED WELL:</b> <i>34</i> ft.                  Depth(s) Groundwater Encountered: 1) <i>14</i> ft.                  2) <i> </i> ft. 3) <i> </i> ft. or 4) <input type="checkbox"/> Dry Well                  WELL'S STATIC WATER LEVEL: <i>14.45</i> ft. TOC  <input checked="" type="checkbox"/> below land surface, measured on (mo-day-yr) <i>2/14/20</i>  <input type="checkbox"/> above land surface, measured on (mo-day-yr) <i> </i>                  Pump test data: Well water was <i> </i> ft. after <i> </i> hours pumping <i> </i> gpm                  Well water was <i> </i> ft. after <i> </i> hours pumping <i> </i> gpm                  Estimated Yield: <i> </i> gpm                  Bore Hole Diameter: <i>3.25</i> in. to <i>34</i> ft. and <i> </i> in. to <i> </i> ft.</p>	<p><b>5 Latitude:</b> <i>37.69477</i> (decimal degrees)  <b>Longitude:</b> <i>97.33371</i> (decimal degrees)                  Horizontal Datum: <input checked="" type="checkbox"/> WGS 84 <input type="checkbox"/> NAD 83 <input type="checkbox"/> NAD 27                  Source for Latitude/Longitude:  <input checked="" type="checkbox"/> GPS (unit make/model: <i>Garmin c60</i>)                  (WAAS enabled? <input checked="" type="checkbox"/> Yes <input type="checkbox"/> No)  <input type="checkbox"/> Land Survey <input type="checkbox"/> Topographic Map  <input type="checkbox"/> Online Mapper: <i> </i></p>
-- NW --	-- NE --																			
W		E																		
-- SW --	-- SE --																			
S																				

**7 WELL WATER TO BE USED AS:**

1. Domestic: <input type="checkbox"/> Household <input type="checkbox"/> Lawn & Garden <input type="checkbox"/> Livestock 2. <input type="checkbox"/> Irrigation 3. <input type="checkbox"/> Feedlot 4. <input type="checkbox"/> Industrial	5. <input type="checkbox"/> Public Water Supply: well ID <i> </i> 6. <input type="checkbox"/> Dewatering: how many wells? <i> </i> 7. <input type="checkbox"/> Aquifer Recharge: well ID <i> </i> 8. <input checked="" type="checkbox"/> Monitoring: well ID <i>NWL-27D</i> 9. Environmental Remediation: well ID <i> </i> <input type="checkbox"/> Air Sparge <input type="checkbox"/> Soil Vapor Extraction <input type="checkbox"/> Recovery <input type="checkbox"/> Injection	10. <input type="checkbox"/> Oil Field Water Supply: lease <i> </i> 11. Test Hole: well ID <i> </i> <input type="checkbox"/> Cased <input type="checkbox"/> Uncased <input type="checkbox"/> Geotechnical 12. Geothermal: how many bores? <i> </i> a) Closed Loop <input type="checkbox"/> Horizontal <input type="checkbox"/> Vertical b) Open Loop <input type="checkbox"/> Surface Discharge <input type="checkbox"/> Inj. of Water 13. <input type="checkbox"/> Other (specify): <i> </i>
--	--	---

Was a chemical/bacteriological sample submitted to KDHE?  Yes  No If yes, date sample was submitted:   
 Water well disinfected?  Yes  No


**8 TYPE OF CASING USED:**  Steel  PVC  Other  CASING JOINTS:  Glued  Clamped  Welded  Threaded  
 Casing diameter *1.25* in. to *2.4* ft., Diameter  in. to  ft., Diameter  in. to  ft.  
 Casing height above land surface *-0.3* in. Weight  lbs./ft. Wall thickness or gauge No. *Sch. 40*  
**TYPE OF SCREEN OR PERFORATION MATERIAL:**  
 Steel  Stainless Steel  Fiberglass  PVC  Other (Specify)   
 Brass  Galvanized Steel  Concrete tile  None used (open hole)  
**SCREEN OR PERFORATION OPENINGS ARE:**  
 Continuous Slot  Mill Slot  Gauze Wrapped  Torch Cut  Drilled Holes  Other (Specify)   
 Louvered Shutter  Key Punched  Wire Wrapped  Saw Cut  None (Open Hole)  
**SCREEN-PERFORATED INTERVALS:** From *24* ft. to *34* ft., From  ft. to  ft., From  ft. to  ft.  
**GRAVEL PACK INTERVALS:** From *20* ft. to *34* ft., From  ft. to  ft., From  ft. to  ft.

**9 GROUT MATERIAL:**  Neat cement  Cement grout  Bentonite  Other   
 Grout Intervals: From *2* ft. to *20* ft., From  ft. to  ft., From  ft. to  ft.  
**Nearest source of possible contamination:**  
 Septic Tank  Lateral Lines  Pit Privy  Livestock Pens  Insecticide Storage  
 Sewer Lines  Cess Pool  Sewage Lagoon  Fuel Storage  Abandoned Water Well  
 Watertight Sewer Lines  Seepage Pit  Feedyard  Fertilizer Storage  Oil Well/Gas Well  
 Other (Specify)   
 Direction from well?  Distance from well?  ft.

10 FROM	TO	LITHOLOGIC LOG	FROM	TO	LITHO. LOG (cont.) or PLUGGING INTERVALS
0	6	<i>Silty Clay</i>			
6	34	<i>Sand</i>			
34	-	<i>Shale</i>			

Notes: Lithologic log based on Electrical Conductivity logging data.

**11 CONTRACTOR'S OR LANDOWNER'S CERTIFICATION:** This water well was  constructed,  reconstructed, or  plugged under my jurisdiction and was completed on (mo-day-year) *2/17/2020* and this record is true to the best of my knowledge and belief. Kansas Water Well Contractor's License No. *710* This Water Well Record was completed on (mo-day-year) *3/10/2020* under the business name of *Below Ground Surface, Inc.* Signature *[Signature]*

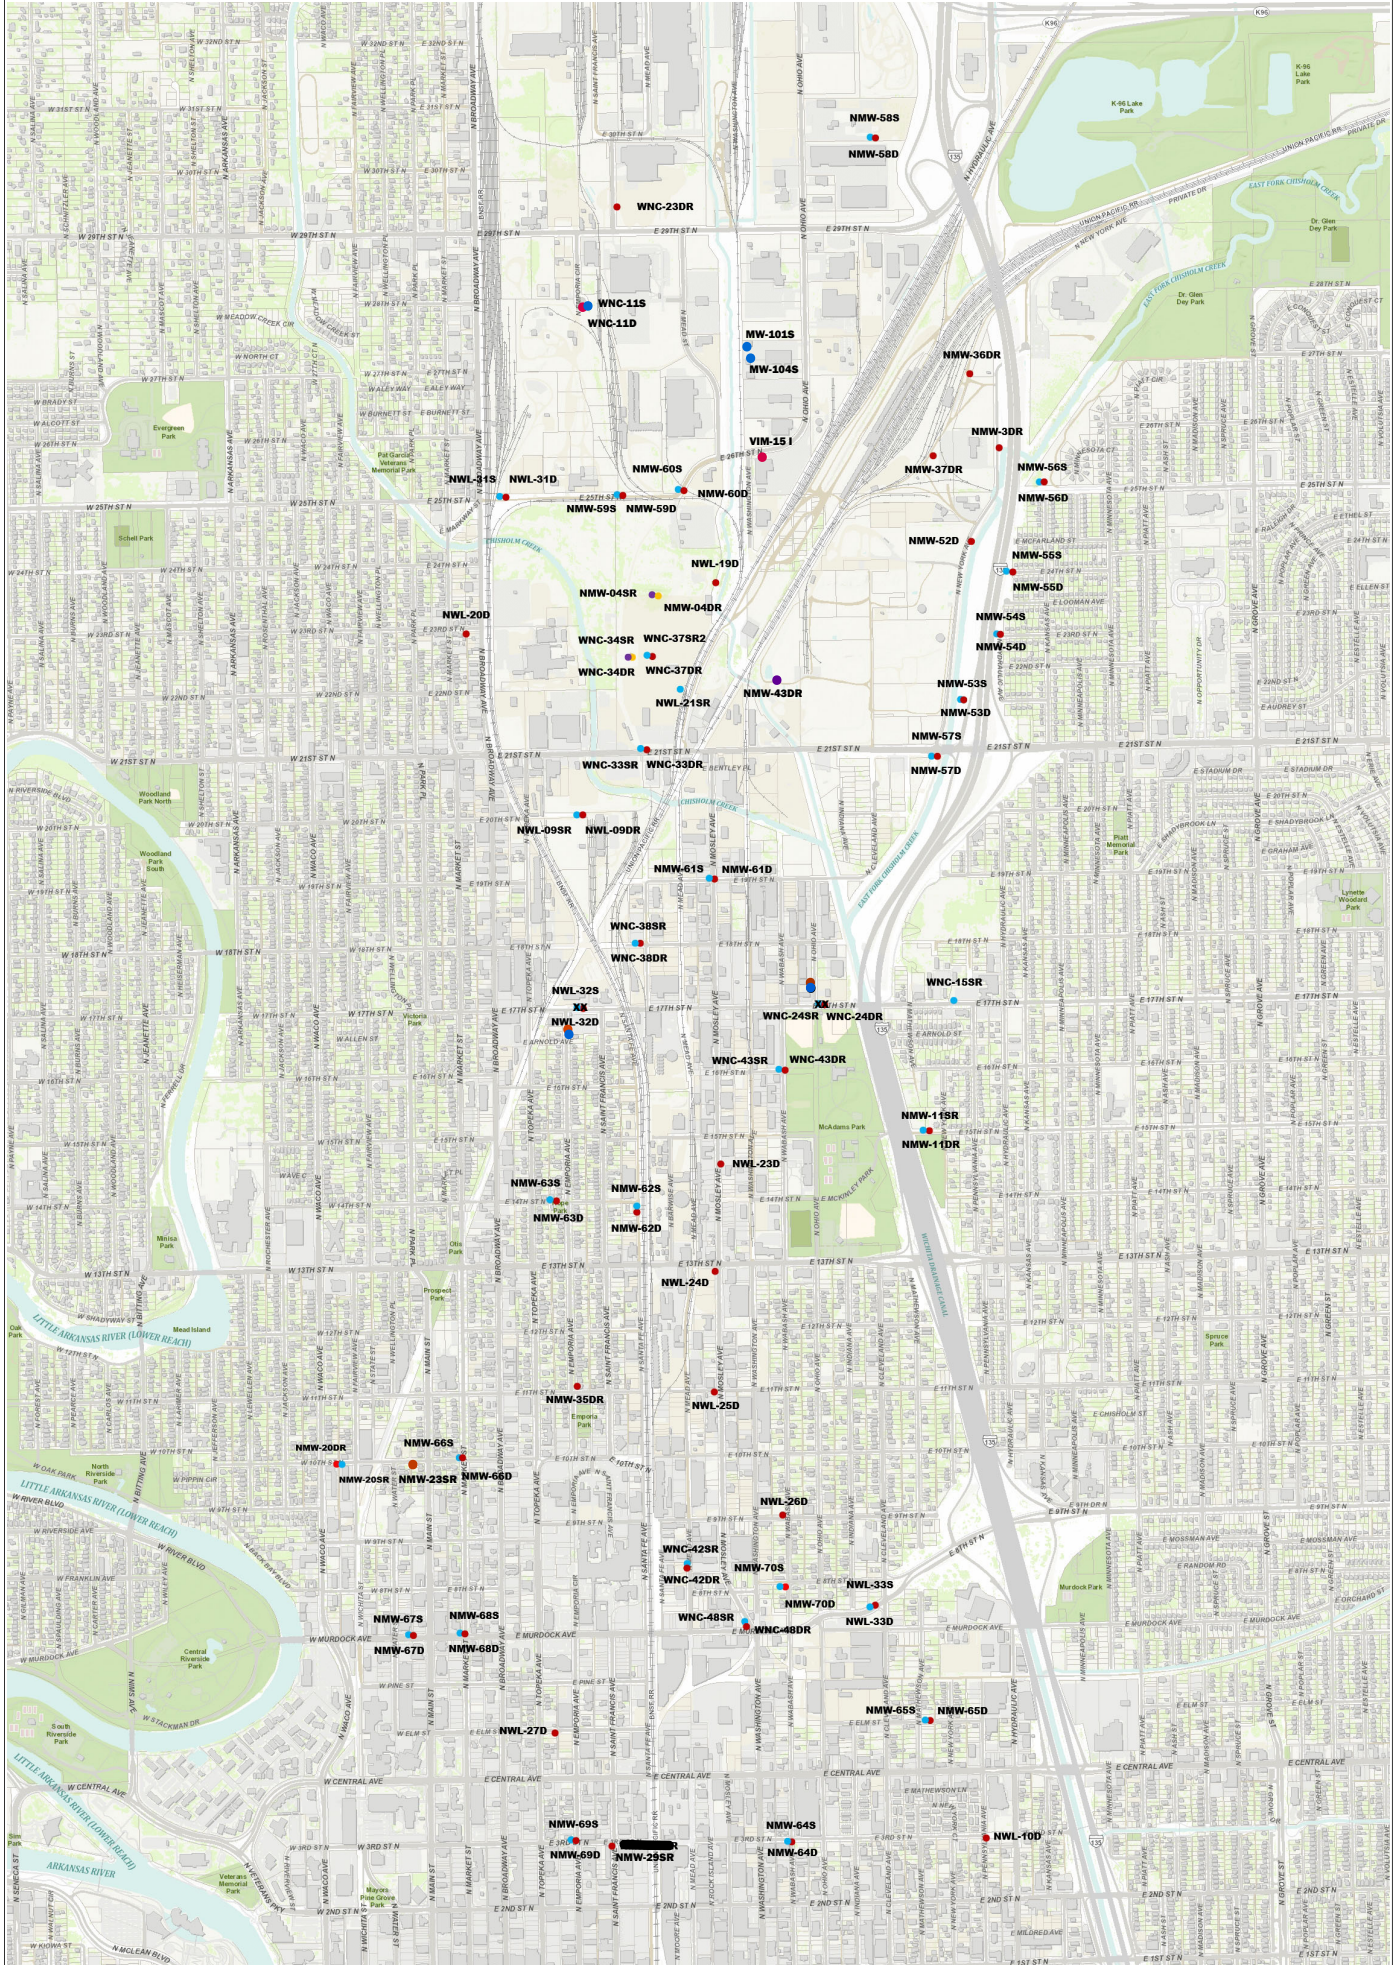

1:2000 0 600.00 1,200.00 Feet  
This information is not an official record, and cannot be used as such. The user should rely only upon official records available from the custodian of records in the appropriate City and/or County department. Some data provided here was used for the preparation of these maps has been obtained from public records not created or maintained by the City of Wichita.  
Map Created On: 06/19 10:37 AM

- Shallow Monitoring Well with Stickup Surface Completion
- Deep Monitoring Well with Stickup Surface Completion
- Shallow Monitoring Well with Flushmount Surface Completion
- Deep Monitoring Well with Flushmount Surface Completion

1:7,200