




Gilbert & Mosley: Proposed MW-989B Location

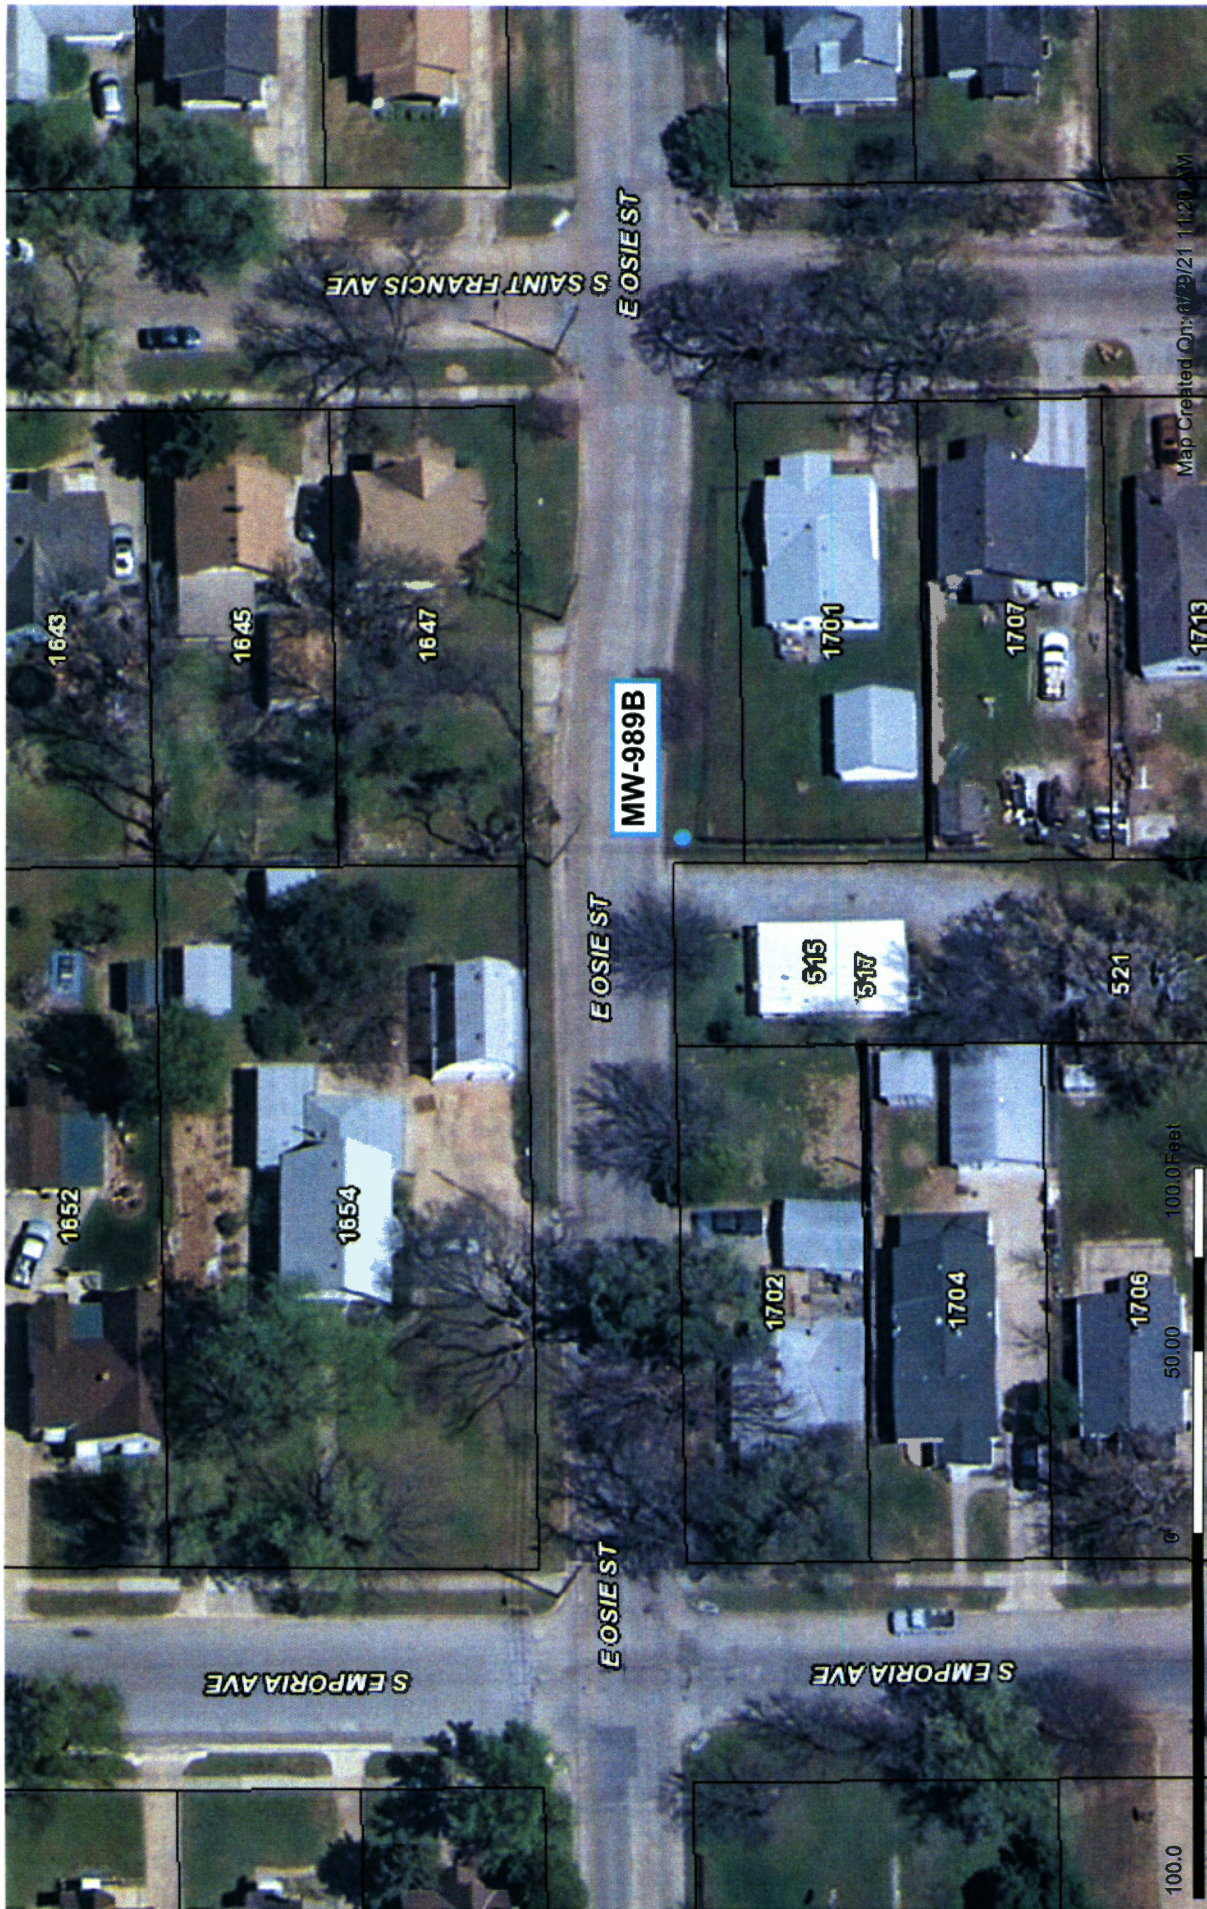

Map Created On: 6/29/21 11:20 AM

100.0

50.00

100.0 Feet

This information is not an official record, and cannot be used as such. The user should rely only upon official records available from the custodian of records in the appropriate City and/or County department. Some data provided here and used for the preparation of these maps has been obtained from public records not created or maintained by the City of Wichita.

1: 600

