

WATER WELL PLUGGING RECORD Form WWC-5P

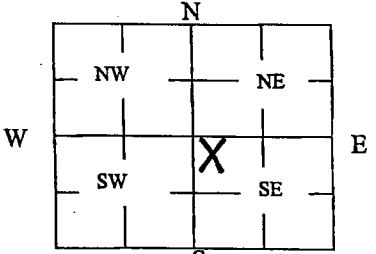
KSA 82a-1212

ID NO.

1 LOCATION OF WATER WELL: County: SEDGWICK Fraction: 1/4 NE 1/4 NW 1/4 SE 1/4 Section Number: 31 Township Number: T 27 S Range Number: 1 ☒ E ☐ W

Street/Rural Address of Well Location; if unknown, distance & direction from nearest town or intersection: If at owner's address, check here ☒ Global Positioning Systems (GPS) information: Latitude: 37.65771 (in decimal degrees) Longitude: -97.35833 (in decimal degrees) Elevation: _____ Horizontal Datum: ☒ WGS84, ☐ NAD83, ☐ NAD27 Collection Method: _____

2 WATER WELL OWNER: PRAIRIE HOMESTEAD RR#, St. Address, Box #: 1605 W. MAY City, State ZIP Code: WICHITA, KS. 67213 GPS unit (Make/Model): _____ ☒ Digital Map/Photo, ☐ Topographic Map, ☐ Land Survey Est. Accuracy: ☐ < 3 m, ☐ 3-5 m, ☐ 5-15 m, ☐ > 15 m

3 MARK WELL'S LOCATION WITH AN "X" IN SECTION BOX:  4 DEPTH OF WELL ? ft. WELL'S STATIC WATER LEVEL ? ft. } **WELL CASING COLLAPSED.** WELL WAS USED AS: ☐ Domestic ☐ Public Water Supply ☐ Dewatering ☐ Irrigation ☐ Oil Field Water Supply ☐ Monitoring ☐ Feedlot ☒ Domestic (Lawn & Garden) ☒ Injection Well ☐ Industrial ☐ Air Conditioning ☐ Other DISCHARGE Was a chemical/bacteriological sample submitted to Department? Yes ☐ No ☐

5 TYPE OF BLANK CASING USED: DUCTILE IRON ☐ Steel ☐ RMP (SR) ☒ Wrought ☐ Fiberglass ☐ Other (Specify below) ☐ PVC ☐ ABS ☐ Asbestos-Cement ☐ Concrete Tile Blank casing diameter 4 in. Was casing pulled? Yes ☐ No ☒ If yes, how much _____ Casing height above or below land surface -0- in.

6 GROUT PLUG MATERIAL: ☐ Neat cement ☒ Cement grout ☐ Bentonite ☐ Other _____ Grout Plug Intervals: From _____ ft. to _____ ft., From _____ ft. to _____ ft., From _____ ft. to _____ ft. What is the nearest source of possible contamination: ☒ Septic tank ☐ Seepage pit ☐ Fuel storage ☐ Other (specify below) ☐ Sewer lines ☐ Pit privy ☐ Fertilizer storage ☐ Watertight sewer lines ☐ Sewage lagoon ☐ Insecticide storage ☐ Lateral lines ☐ Feedyard ☐ Abandoned water well ☐ Oil well/Gas well Direction from well? SOUTH ☐ Cess pool ☐ Livestock pens ☐ How many feet? 2'

FROM	TO	PLUGGING MATERIALS	FROM	TO	PLUGGING MATERIALS
		<u>DISINFECTED WELL</u>			<u>THIS DISCHARGE WELL</u>
		<u>PUT IN PEA PERBBLES</u>			<u>IS 16' NW OF PUMP</u>
		<u>TOPPED WITH CONCRETE</u>			<u>WELL.</u>

7 CONTRACTOR'S OR LANDOWNER'S CERTIFICATION: This water well was plugged under my jurisdiction and was completed on (mo/day/year) 3-2-22 and this record is true to the best of my knowledge and belief. Kansas Water Well Contractor's License No. _____ This Water Well Record was completed on (mo/day/year) 3-2-22 under the business name of DON VAUGHN, INC. by (signature) Don Vaughn

Send one white copy to Kansas Department of Health & Environment, Geology Section, 1000 SW Jackson Street, Ste. 420, Topeka, KS 66612-1367. Send one copy to WATER WELL OWNER and retain one for your records. Visit us at <http://www.kdheks.gov/waterwell/index.html> Telephone 785-296-5524.

KSA82a-1212

Revised 1/20/2015