

**WATER WELL PLUGGING RECORD Form WWC-5P**


KSA 82a-1212 ID NO.

MW-170

<b>1 LOCATION OF WATER WELL:</b> County: <u>Sedgwick</u>	Fraction <u>NW 1/4 SE 1/4 SW 1/4 SE 1/4</u>	Section Number <u>9</u>	Township Number <u>27 T S</u>	Range Number <u>1</u> <input checked="" type="checkbox"/> E <input type="checkbox"/> W
---	--	----------------------------	----------------------------------	---

Street/Rural Address of Well Location; if unknown, distance & direction from nearest town or intersection: If at owner's address, check here <input type="checkbox"/> <u>2561 N. New York St. Wichita, KS 67214</u>	<b>Global Positioning Systems (GPS) information:</b> Latitude: <u>37.723859</u> (in decimal degrees) Longitude: <u>-97.323694</u> (in decimal degrees) Elevation: _____ Horizontal Datum: <input type="checkbox"/> WGS84, <input type="checkbox"/> NAD83, <input type="checkbox"/> NAD27 Collection Method: _____
---	--

<b>2 WATER WELL OWNER:</b> <u>R.R.M. Properties, L.L.C.</u> RR#, St. Address, Box #: <u>800 E 21st Street N</u> City, State ZIP Code: <u>Wichita, KS 67214</u>	<input checked="" type="checkbox"/> GPS unit (Make/Model: <u>iPhone with GPS Tracks App.</u> ) <input type="checkbox"/> Digital Map/Photo, <input type="checkbox"/> Topographic Map, <input type="checkbox"/> Land Survey Est. Accuracy: <input type="checkbox"/> < 3 m, <input checked="" type="checkbox"/> 3-5 m, <input type="checkbox"/> 5-15 m, <input type="checkbox"/> > 15 m
--	--

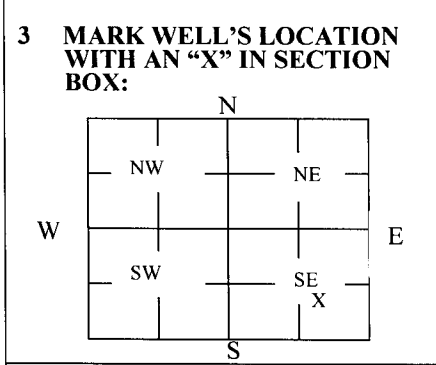

**4 DEPTH OF WELL** 23 ft.  
WELL'S STATIC WATER LEVEL 17.62 ft.  
WELL WAS USED AS:  
 Domestic       Public Water Supply       Dewatering  
 Irrigation       Oil Field Water Supply       Monitoring  
 Feedlot       Domestic (Lawn & Garden)       Injection Well  
 Industrial       Air Conditioning       Other \_\_\_\_\_  
 Was a chemical/bacteriological sample submitted to Department? Yes  No

**5 TYPE OF BLANK CASING USED:**

Steel     RMP (SR)     Wrought     Fiberglass     Other (Specify below) \_\_\_\_\_  
 PVC     ABS     Asbestos-Cement     Concrete Tile

Blank casing diameter 2 in. Was casing pulled? Yes  No  If yes, how much 5  
 Casing height above or below land surface 36 in.

**6 GROUT PLUG MATERIAL:**  Neat cement     Cement grout     Bentonite     Other \_\_\_\_\_

Grout Plug Intervals: From 23 ft. to 3 ft., From \_\_\_\_\_ ft. to \_\_\_\_\_ ft., From \_\_\_\_\_ ft. to \_\_\_\_\_ ft.

What is the nearest source of possible contamination:  
 Septic tank     Seepage pit     Fuel storage     Other (specify below) Located at remediation site  
 Sewer lines     Pit privy     Fertilizer storage  
 Watertight sewer lines     Sewage lagoon     Insecticide storage  
 Lateral lines     Feedyard     Abandoned water well    Direction from well? \_\_\_\_\_  
 Cess pool     Livestock pens     Oil well/Gas well    How many feet? \_\_\_\_\_

FROM	TO	PLUGGING MATERIALS	FROM	TO	PLUGGING MATERIALS

**7 CONTRACTOR'S OR LANDOWNER'S CERTIFICATION:** This water well was plugged under my jurisdiction and was completed on (mo/day/year) 01/03/2022 and this record is true to the best of my knowledge and belief. Kansas Water Well Contractor's License No. PG #555. This Water Well Record was completed on (mo/day/year) 01/07/2022 under the business name of R.R.M. Properties, L.L.C. by (signature) \_\_\_\_\_