

WATER WELL PLUGGING RECORD Form WWC-5P

KSA 82a-1212 ID NO.


T-06

1 LOCATION OF WATER WELL: Fraction K6S ORL Section Number 9 Township Number 27 T S Range Number 1 E W
 County: Sedgwick NW 1/4 SE 1/4 NE 1/4

Street/Rural Address of Well Location; if unknown, distance & direction from nearest town or intersection: If at owner's address, check here 2561 N. New York St. Wichita, KS 67214

Global Positioning Systems (GPS) information:
 Latitude: 37.720285 (in decimal degrees)
 Longitude: -97.323465 (in decimal degrees)
 Elevation: _____
 Horizontal Datum: WGS84, NAD83, NAD27
 Collection Method: GPS unit (Make/Model: iPhone with GPS Tracks App.)
 Digital Map/Photo, Topographic Map, Land Survey
 Est. Accuracy: < 3 m, 3-5 m, 5-15 m, > 15 m

2 WATER WELL OWNER: R.R.M. Properties, L.L.C.
 RR#, St. Address, Box #: 800 E 21st Street N
 City, State ZIP Code: Wichita, KS 67214

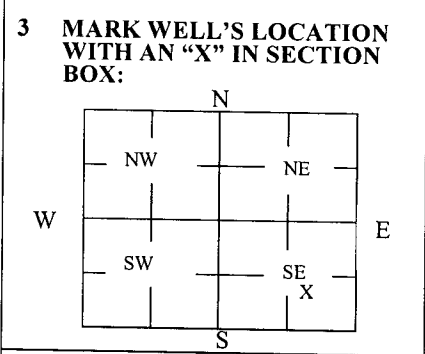

4 DEPTH OF WELL 25 ft.
 WELL'S STATIC WATER LEVEL 13.12 ft.
 WELL WAS USED AS:
 Domestic Public Water Supply Dewatering
 Irrigation Oil Field Water Supply Monitoring
 Feedlot Domestic (Lawn & Garden) Injection Well
 Industrial Air Conditioning Other _____
 Was a chemical/bacteriological sample submitted to Department? Yes No

5 TYPE OF BLANK CASING USED:

Steel RMP (SR) Wrought Fiberglass Other (Specify below) _____
 PVC ABS Asbestos-Cement Concrete Tile

Blank casing diameter 4 in. Was casing pulled? Yes No If yes, how much 5 in.
 Casing height above or below land surface 36 in.

6 GROUT PLUG MATERIAL: Neat cement Cement grout Bentonite Other _____

Grout Plug Intervals: From 25 ft. to 3 ft., From _____ ft. to _____ ft., From _____ ft. to _____ ft.

What is the nearest source of possible contamination:
 Septic tank Seepage pit Fuel storage Other (specify below) _____
 Sewer lines Pit privy Fertilizer storage Located at remediation site
 Watertight sewer lines Sewage lagoon Insecticide storage
 Lateral lines Feedyard Abandoned water well
 Cess pool Livestock pens Oil well/Gas well
 Direction from well? _____
 How many feet? _____

FROM	TO	PLUGGING MATERIALS	FROM	TO	PLUGGING MATERIALS

7 CONTRACTOR'S OR LANDOWNER'S CERTIFICATION: This water well was plugged under my jurisdiction and was completed on (mo/day/year) 01/03/2022 and this record is true to the best of my knowledge and belief. Kansas Water Well Contractor's License No. PG #555. This Water Well Record was completed on (mo/day/year) 01/07/2022 under the business name of R.R.M. Properties, L.L.C. by (signature) _____

Send one white copy to Kansas Department of Health & Environment, Geology Section, 1000 SW Jackson Street, Ste. 420, Topeka, KS 66612-1367. Send one copy to WATER WELL OWNER and retain one for your records.
 Visit us at <http://www.kdheks.gov/waterwell/index.html> Telephone 785-296-5524.