

WATER WELL PLUGGING RECORD Form WWC-5P

KSA 82a-1212

ID NO.

MW-507A

1 LOCATION OF WATER WELL: County: Sedgwick Fraction NW 1/4 NE 1/4 SW 1/4 NW 1/4 Section Number 28 Township Number T 27 S Range Number 1 E W

Street/Rural Address of Well Location; if unknown, distance & direction from nearest town or intersection: If at owner's address, check here

Wichita, Ks.
150' N. of NW corner of intersection of S. Emporia Ave. + E. Gilbert St. (St.)

Global Positioning Systems (GPS) information:


Latitude: 37.67500 (in decimal degrees)
Longitude: -97.33319 (in decimal degrees)

Elevation: _____
Horizontal Datum: WGS84, NAD83, NAD27
Collection Method: _____

2 WATER WELL OWNER: City of Wichita
RR#, St. Address, Box #: 455 N. Main
City, State ZIP Code: Wichita, KS 67202

GPS unit (Make/Model): _____
 Digital Map/Photo, Topographic Map, Land Survey
Est. Accuracy: < 3 m, 3-5 m, 5-15 m, > 15 m

3 MARK WELL'S LOCATION WITH AN "X" IN SECTION BOX:

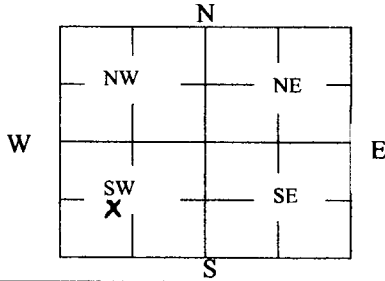

4 DEPTH OF WELL 28.9 **ft.**

WELL'S STATIC WATER LEVEL 17.05 ft

WELL WAS USED AS:

- Domestic
- Irrigation
- Feedlot
- Industrial
- Public Water Supply
- Oil Field Water Supply
- Domestic (Lawn & Garden)
- Air Conditioning
- Dewatering
- Monitoring
- Injection Well
- Other _____

Was a chemical/bacteriological sample submitted to Department? Yes No

5 TYPE OF BLANK CASING USED:

- Steel
- RMP (SR)
- Wrought
- Fiberglass
- Other (Specify below) _____
- PVC
- ABS
- Asbestos-Cement
- Concrete Tile

Blank casing diameter 4 in. Was casing pulled? Yes No If yes, how much 5 ft.
Casing height above or below land surface 0 in.

6 GROUT PLUG MATERIAL: Neat cement Cement grout Bentonite Other _____

Grout Plug Intervals: From 0 ft. to 28.9 ft., From _____ ft. to _____ ft., From _____ ft. to _____ ft.

What is the nearest source of possible contamination:

- Septic tank
 - Sewer lines
 - Watertight sewer lines
 - Lateral lines
 - Cess pool
 - Seepage pit
 - Pit privy
 - Sewage lagoon
 - Feedyard
 - Livestock pens
 - Fuel storage
 - Fertilizer storage
 - Insecticide storage
 - Abandoned water well
 - Oil well/Gas well
 - Other (specify below) Gilbert Mosely Plume
- Direction from well? _____
How many feet? _____

FROM	TO	PLUGGING MATERIALS	FROM	TO	PLUGGING MATERIALS
<u>1</u>	<u>28.9</u>	<u>Bentonite (0-1' Top 5:1)</u>			

7 CONTRACTOR'S OR LANDOWNER'S CERTIFICATION: This water well was plugged under my jurisdiction and was completed on (mo/day/year) 12/14/2022 and this record is true to the best of my knowledge and belief. Kansas Water Well Contractor's License No. 604. This Water Well Record was completed on (mo/day/year) 12/28/22 under the business name of Environmental Priority Service, Inc. by (signature) [Signature]

Send one white copy to Kansas Department of Health & Environment, Geology Section, 1000 SW Jackson Street, Ste. 420, Topeka, KS 66612-1367. Send one copy to WATER WELL OWNER and retain one for your records.
Visit us at <http://www.kdheks.gov/waterwell/index.html> Telephone 785-296-5524.