

1 LOCATION OF WATER WELL: Fraction NE 1/4 SE 1/4 SW 1/4 Section Number 7 Township Number T 27 S Range Number R 1 E/W

Distance and direction from nearest town or city street address of well if located within city?

1580 N. Clarence Wichita, Ks

2 WATER WELL OWNER: Durwood Henricks


RR#, St. Address, Box #: 1580 N. Clarence

City, State, ZIP Code: Wichita, KS 67203

Board of Agriculture, Division of Water Resources

Application Number:

3 LOCATE WELL'S LOCATION WITH AN "X" IN SECTION BOX:

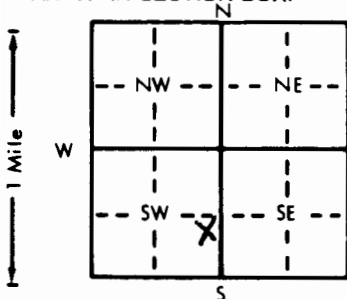

4 DEPTH OF COMPLETED WELL: 32 ft. ELEVATION:

Depth(s) Groundwater Encountered 1. 17 ft. 2. ft. 3. ft.

WELL'S STATIC WATER LEVEL 17 ft. below land surface measured on mo/day/yr 6-14-84

Pump test data: Well water was 19 ft. after 2 hours pumping 20 gpm

Est. Yield 22 gpm Well water was ft. after hours pumping gpm

Bore Hole Diameter 8 1/2 in. to 14 ft. and 5 1/4 in. to 32 ft.

WELL WATER TO BE USED AS: 5 Public water supply 8 Air conditioning 11 Injection well

1 Domestic 3 Feedlot 6 Oil field water supply 9 Dewatering 12 Other (Specify below)

2 Irrigation 4 Industrial 7 Lawn and garden only 10 Observation well

Was a chemical/bacteriological sample submitted to Department? Yes No If yes, mo/day/yr sample was submitted

Water Well Disinfected? Yes No

5 TYPE OF BLANK CASING USED:

1 Steel 3 RMP (SR)

2 PVC 4 ABS

Blank casing diameter 5 1/4 in. to 26 ft. Dia.

Casing height above land surface 14 in. weight lbs./ft. Wall thickness or gauge No. Sch. 40

TYPE OF SCREEN OR PERFORATION MATERIAL:

1 Steel 3 Stainless steel

2 Brass 4 Galvanized steel

SCREEN OR PERFORATION OPENINGS ARE:

1 Continuous slot 3 Mill slot

2 Louvered shutter 4 Key punched

SCREEN-PERFORATED INTERVALS:

From 27 ft. to 32 ft. From ft. to ft. From ft. to ft. From ft. to ft.

GRAVEL PACK INTERVALS: From 16 ft. to 32 ft. From ft. to ft. From ft. to ft. From ft. to ft.

6 GROUT MATERIAL:

1 Neat cement

2 Cement grout

3 Bentonite

4 Other

Grout Intervals: From 0 ft. to 10 ft. From ft. to ft. From 10 ft. to 16 ft.

What is the nearest source of possible contamination:

1 Septic tank 4 Lateral lines

2 Sewer lines 5 Cess pool

3 Watertight sewer lines 6 Seepage pit

7 Pit privy 8 Sewage lagoon

9 Feedyard 10 Livestock pens

11 Fuel storage 12 Fertilizer storage

13 Insecticide storage 14 Abandoned water well

15 Oil well/Gas well 16 Other (specify below)

Direction from well?

South

How many feet?

30

| FROM | TO | LITHOLOGIC LOG                     | FROM | TO | LITHOLOGIC LOG |
|------|----|------------------------------------|------|----|----------------|
| 0    | 2  | Topsoil                            |      |    |                |
| 2    | 6  | Soil with Fine Sand                |      |    |                |
| 6    | 14 | Soil with Mixed Fine & Coarse Sand |      |    |                |
| 14   | 20 | Fine to medium Sand                |      |    |                |
| 20   | 21 | Fine Sand mixed w/ Clay            |      |    |                |
| 21   | 28 | Medium Sand & Gravel               |      |    |                |
| 28   | 32 | Coarse gravel                      |      |    |                |

7 CONTRACTOR'S OR LANDOWNER'S CERTIFICATION: This water well was (1) constructed, (2) reconstructed, or (3) plugged under my jurisdiction and was completed on (mo/day/year) 6-14-84 and this record is true to the best of my knowledge and belief. Kansas

Water Well Contractor's License No. 443 This Water Well Record was completed on (mo/day/yr) 6-15-84

under the business name of Smith Well Drilling by (signature) Rodney W. Smith

INSTRUCTIONS: Use typewriter or ball point pen, PLEASE PRESS FIRMLY and PRINT clearly. Please fill in blanks, underline or circle the correct answers. Send top three copies to Kansas Department of Health and Environment, Division of Environment, Environmental Geology Section, Topeka, KS 66620. Send one to WATER WELL OWNER and retain one for your records.