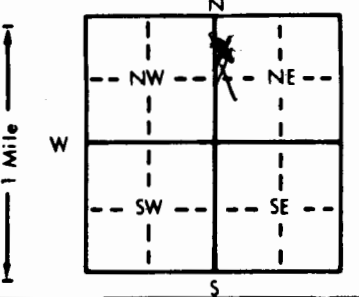


County: <u>Sedgwick</u>					
Distance and direction from nearest town or city street address of well if located within city?					
2 WATER WELL OWNER: <u>JEFFREY G. TOLBERG</u>					
RR#, St. Address, Box #: <u>2118 MENLO</u>					
City, State, ZIP Code: <u>WICHITA, KS 67211</u>					
Board of Agriculture, Division of Water Resources Application Number:					
3 LOCATE WELL'S LOCATION WITH AN "X" IN SECTION BOX:		4 DEPTH OF COMPLETED WELL <u>Approx 10-15</u> ft. ELEVATION:			
		Depth(s) Groundwater Encountered 1. ft. 2. ft. 3. ft.			
		WELL'S STATIC WATER LEVEL <u>Approx 10-15</u> ft. below land surface measured on mo/day/yr			
		Pump test data: Well water was ft. after hours pumping gpm			
		Est. Yield gpm: Well water was ft. after hours pumping gpm			
		Bore Hole Diameter in. to ft., and in. to ft.			
WELL WATER TO BE USED AS:		5 Public water supply 8 Air conditioning 11 Injection well			
<u>1 Domestic</u>		3 Feedlot 6 Oil field water supply 9 Dewatering 12 Other (Specify below)			
2 Irrigation 4 Industrial 7 Lawn and garden only 10 Monitoring well					
Was a chemical/bacteriological sample submitted to Department? Yes <u>X</u> No If yes, mo/day/yr sample was submitted					
Water Well Disinfected? Yes <u>NA</u> No <u>X</u>					
5 TYPE OF BLANK CASING USED:					
1 Steel		3 RMP (SR)		5 Wrought iron	
<u>2 PVC</u>		4 ABS		6 Asbestos-Cement	
				7 Fiberglass	
Blank casing diameter in. to ft., Dia		Casing height above land surface <u>3 ft. Below</u> in., weight		lbs./ft. Wall thickness or gauge No.	
TYPE OF SCREEN OR PERFORATION MATERIAL:					
1 Steel		3 Stainless steel		5 Fiberglass	
2 Brass		4 Galvanized steel		6 Concrete tile	
SCREEN OR PERFORATION OPENINGS ARE:		5 Gauzed wrapped		8 Saw cut	
1 Continuous slot		3 Mill slot		6 Wire wrapped	
2 Louvered shutter		4 Key punched		7 Torch cut	
SCREEN-PERFORATED INTERVALS:		From <u>NA</u> ft. to <u>NA</u> ft., From		ft. to	
GRAVEL PACK INTERVALS:		From		ft. to	
6 GROUT MATERIAL: <u>15 Neat cement</u> 2 Cement grout 3 Bentonite 4 Other					
Grout Intervals: From ft. to ft., From ft. to ft., From ft. to ft.					
What is the nearest source of possible contamination:					
1 Septic tank		4 Lateral lines		7 Pit privy	
<u>2 Sewer lines</u>		5 Cess pool		8 Sewage lagoon	
3 Watertight sewer lines		6 Seepage pit		9 Feedyard	
Direction from well? <u>NORTH</u>		How many feet? <u>2-3 ft</u>			
FROM	TO	LITHOLOGIC LOG	FROM	TO	PLUGGING INTERVALS
			<u>15</u>	<u>14.5</u>	<u>Sand & GRAVEL</u>
			<u>14.5</u>	<u>0</u>	<u>Cement</u>
7 CONTRACTOR'S OR LANDOWNER'S CERTIFICATION: This water well was (1) constructed, (2) reconstructed, or (3) <u>plugged</u> under my jurisdiction and was completed on (mo/day/year) <u>9-12-93</u> and this record is true to the best of my knowledge and belief. Kansas Water Well Contractor's License No. This Water Well Record was completed on (mo/day/yr) <u>9-14-93</u> under the business name of by (signature) <u>[Signature]</u>					
INSTRUCTIONS: Use typewriter or ball point pen. PLEASE PRESS FIRMLY and PRINT clearly. Please fill in blanks, underline or circle the correct answers. Send top three copies to Kansas Department of Health and Environment, Bureau of Water, Topeka, Kansas 66620-0001. Telephone: 913-296-5545. Send one to WATER WELL OWNER and retain one for your records.					