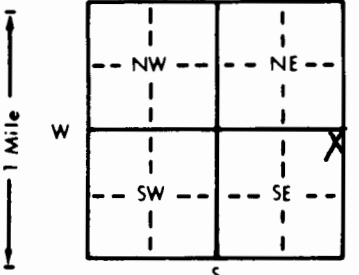


MW-1 2011071

1 LOCATION OF WATER WELL: County: <u>Sedgwick</u>	Fraction <u>NE 1/4 NE 1/4 SE 1/4</u>	Section Number <u>3</u>	Township Number T <u>27</u> S	Range Number R <u>1</u> <u>E/W</u>
--	---	----------------------------	----------------------------------	---------------------------------------

Distance and direction from nearest town or city street address of well if located within city?
2545 N. Hillside, Wichita

2 WATER WELL OWNER: RR#, St. Address, Box # : City, State, ZIP Code	<u>Clyde Jones</u> <u>2400 Gentry</u> <u>Wichita KS 67220</u>	Board of Agriculture, Division of Water Resources Application Number:
---	---	--

3 LOCATE WELL'S LOCATION WITH AN "X" IN SECTION BOX: 	4 DEPTH OF COMPLETED WELL: <u>17</u> ft. ELEVATION: Depth(s) Groundwater Encountered 1. <u>11</u> ft. 2. <u>11</u> ft. 3. <u>11</u> ft. WELL'S STATIC WATER LEVEL <u>4.
--	--

Mill slot 5 Gauzed wrapped 8 Saw cut 11 None (open hole) 2 Louvered shutter 4 Key punched 6 Wire wrapped 9 Drilled holes SCREEN-PERFORATED INTERVALS: From <u>7</u> ft. to <u>17</u> ft., 
--	--


--

FROM	TO	LITHOLOGIC LOG	FROM	TO	PLUGGING INTERVALS
0.0	0.5	concrete			
0.5	8.5	Shale, black, highly weathered, soft			
8.5	13.5	Shale, Olive to gray, highly weathered, soft			
13.5	15.0	Shale, Olive to light gray, highly weathered, brittle			
Flush mount waiver granted 3-18-93 for Mart 74 by Don Taylor					

7 CONTRACTOR'S OR LANDOWNER'S CERTIFICATION: This water well was <u>(1) constructed</u> , (2) reconstructed, or (3) plugged under my jurisdiction and was completed on (mo/day/year) <u>5-6-93</u> and this record is true to the best of my knowledge and belief. Kansas Water Well Contractor's License No. <u>531</u> This Water Well Record was completed on (mo/day/yr) <u>5-14-93</u> under the business name of <u>GSI</u> by (signature) <u>Allison Irwin</u>
