

CORRECTION TO WATER WELL RECORD (WWC-5)

The following correction(s) was made to the attached WWC-5 log, in order to file the item or to rectify lacking or incorrect information.

Fraction (1/4 1/4 1/4) Section-Township-Range changed:

listed as 4-27S-1E

changed to NW NW NE, 4-27S-1E

Other changes: Initial statements: _____

Changed to: _____

Comments: _____

verification method: well address on form, legal description, city map,
and Wichita East 1:24,000 topo. map. initials: DRJ date: 10/17/2001

submitted by: Kansas Geological Survey, Data Resources Library, 1930 Constant Ave., Lawrence, KS 66047-3726
to: Kansas Dept of Health & Environment Bureau of Water Industrial Programs, Bldg 283, Forbes Field, KS 66620

USE TYPEWRITER OR BALL POINT PEN—PRESS FIRMLY, PRINT CLEARLY.

T	R	EW	sec	1/4	1/4	1/4	No.				

WATER WELL RECORD
KSA 82a-1201-1215


Kansas State Dept. Of Health
(Water Well Contractors)
Forbes-Bldg. 740
Topeka, Kansas 66620

BILLED TO: Joe Wilson Pump & Well

1 Location of well:	County Sedgwick	Township name Wichita	Fraction	Section number 4	Town number 27S	Range number 1E
---------------------	---------------------------	---------------------------------	----------	----------------------------	---------------------------	---------------------------

Distance and direction from nearest town or city: **2811 North Ohio Wichita, Kansas**
Street address of well location if in city: **2811 North Ohio Wichita, Kansas**

3 Owner of well: **Vim Trailer Mfg. Inc.**
Address: **2547 North Market Wichita, Kansas**

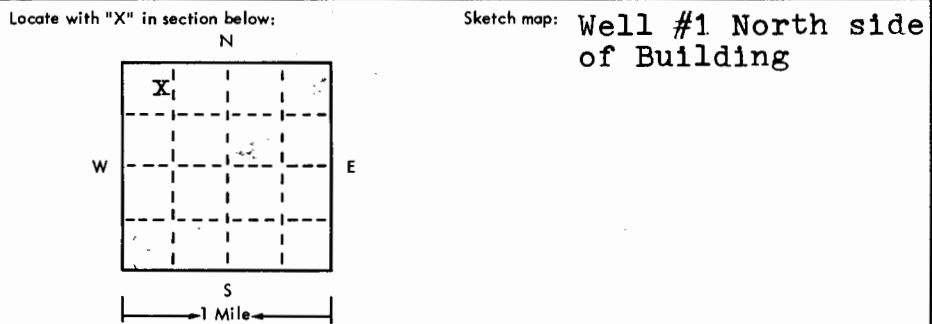

4 Well depth: **40** ft. Date of completion **1-25-75**
Well diameter **16** in.

5 Cable tool Rotary Driven Dug
 Hollow rod Jetted Bored Reverse rotary

6 Use: Domestic Public supply Industry
 Irrigation Air conditioning Commercial
 Test well *** see #16**

7 Casing: Material **PVC** Height: above/below
Threaded Welded Surface **12** in.
Digm. **10** in. to **40** ft. depth; Drive shoe? Yes No
___ in. to ___ ft. depth!

2	Type and color of material	From	To
	Dirt and Clay	0	18
	Medium sand	18	20
	Coarse sand	20	25
	Coarse sand and fine gravel	25	40

8 Screen: **Certain-Teed**
Manufacturer: **PVC** Dia. **10"**
Type: **PVC** Slot/gauze **.070** Length **15'**
Set between **25** ft. and **40** ft.
Fittings: Gravel pack Yes No Size range of material **1/4 - 1/8"**

9 Static water level: **20** ft. below land surface Date **1-25-75**

10 Pumping level below land surfaces:
___ ft. after ___ hrs. pumping ___ g.p.m.
___ ft. after ___ hrs. pumping ___ g.p.m.
Estimated maximum yield ___ g.p.m.

11 Water sample submitted:
 Yes No Date ___

12 Well head completion: **capped**
 Pitless adapter **12** Inches above grade

13 Well grouted? Yes No
 Neat cement Bentonite _____
Depth: From ___ ft. to **12** ft.

14 Nearest source of possible contamination: **NONE**
ft. ___ Direction ___ Type ___
Well disinfected upon completion? Yes No

15 Pump: Not installed
Manufacturer's name ___ HP ___ Volts ___
Model number ___ Length of drop pipe ___ ft. capacity ___ g.m.p.
Type: Submersible Turbine
 Jet Reciprocating
 Centrifugal Other

16 Remarks: elevation **Level ground**
*** Water to be used to fill tank trucks and air conditioning use.**
Topography: Hill Slope Upland Valley
Well is not going to be used for drinking water; usage is to fill tank truck, and air conditioning.

17 Water well contractor's certification:
This well was drilled under my jurisdiction and this report is true to the best of my knowledge and belief.
Harp Well & Pump Serv. 236
Business name: **Wichita, Kansas** License No. **67209**
Address: **Wichita, Kansas**
Signed: **Mary Arnold** Date **2-26-75**
Authorized representative