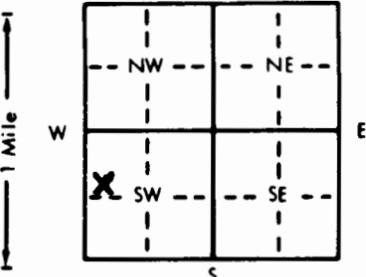


1] LOCATION OF WATER WELL: County: SEDGWICK		FRACTION SW 1/4 NW 1/4 SW 1/4		SECTION NUMBER 4		TOWNSHIP NUMBER T 27 S		RANGE NUMBER R 1 E	
Distance and direction from nearest town or city street address of well if located within city? EAST OF 23RD & Broadway - North of Parking lot									
2] WATER WELL OWNER: WNID - DSTE MEATS RR#, St. Address, Box #: 2300 N. Broadway City, State, ZIP Code: Wichita, KS Ohse Board of Agriculture, Division of Water Resources Application Number:									
3] LOCATE WELL'S LOCATION WITH AN "X" IN SECTION BOX: 			4] DEPTH OF COMPLETED WELL: 39 ft. ELEVATION: Depth(s) Groundwater Encountered 1 14 ft. 2. ft. 3. ft. WELL'S STATIC WATER LEVEL 15.6 ft. below land surface measured on mo/day/yr 6-5-92 Pump test data: Well water was ft. after hours pumping gpm Est. Yield gpm: Well water was ft. after hours pumping gpm Bore Hole Diameter 8 in. to ft., and in. to ft. WELL WATER TO BE USED AS: 1 Domestic 3 Feedlot 6 Oil field water supply 8 Air conditioning 11 Injection well 2 Irrigation 4 Industrial 7 Lawn and garden only 9 Dewatering 12 Other (Specify below) Was a chemical/bacteriological sample submitted to Department? Yes No X ; If yes, mo/day/yr sample was submitted Water Well Disinfected? Yes No X						
5] TYPE OF BLANK CASING USED: 1 Steel 3 RMP (SR) 5 Wrought iron 8 Concrete tile CASING JOINTS: Glued Clamped 2 PVC 4 ABS 6 Asbestos-Cement 9 Other (specify below) Welded Blank casing diameter 2 in. to 29 ft., Dia in. to ft., Dia in. to ft. Casing height above land surface 24 in., weight 169 lbs./ft. Wall thickness or gauge No. 154 TYPE OF SCREEN OR PERFORATION MATERIAL: 1 Steel 3 Stainless steel 5 Fiberglass 7 PVC 10 Asbestos-cement 2 Brass 4 Galvanized steel 6 Concrete tile 8 RMP (SR) 11 Other (specify) 12 None used (open hole) SCREEN OR PERFORATION OPENINGS ARE: 1 Continuous slot 3 Mill slot 5 Gauzed wrapped 8 Saw cut 11 None (open hole) 2 Louvered shutter 4 Key punched 6 Wire wrapped 9 Drilled holes SCREEN-PERFORATED INTERVALS: From 29 ft. to 39 ft., From ft. to ft. GRAVEL PACK INTERVALS: From 25 ft. to 39 ft., From ft. to ft.									
6] GROUT MATERIAL: 1 Neat cement 2 Cement grout 3 Bentonite 4 Other Grout Intervals: From 8 ft. to 25 ft., From 2.5 ft. to 25 ft., From ft. to ft. What is the nearest source of possible contamination: 1 Septic tank 4 Lateral lines 7 Pit privy 10 Livestock pens 14 Abandoned water well 2 Sewer lines 5 Cess pool 8 Sewage lagoon 11 Fuel storage 15 Oil well/Gas well 3 Watertight sewer lines 6 Seepage pit 9 Feedyard 12 Fertilizer storage 16 Other (specify below) Direction from well? EAST 13 Insecticide storage Chisholm Creek How many feet? 1300									
7] CONTRACTOR'S OR LANDOWNER'S CERTIFICATION: This water well was (1) constructed, (2) reconstructed, or (3) plugged under my jurisdiction and was completed on (mo/day/year) 5-1-92 and this record is true to the best of my knowledge and belief. Kansas Water Well Contractor's License No. 517 This Water Well Record was completed on (mo/day/yr) 6-8-92 under the business name of Groundwater Technology, Inc by (signature) Steven R. Mitchell									
INSTRUCTIONS: Use typewriter or ball point pen. PLEASE PRESS FIRMLY and PRINT clearly. Please fill in blanks, underline or circle the correct answers. Send top three copies to Kansas Department of Health and Environment, Bureau of Water, Topeka, Kansas 66620-0001. Telephone: 913-296-5545. Send one to WATER WELL OWNER and retain one for your records.									

~~000079~~