

CORRECTION TO WATER WELL RECORD (WWC-5)

The following correction(s) was made to the attached WWC-5 log, in order to file the item or to rectify lacking or incorrect information.

Fraction ( 1/4 1/4 1/4) Section-Township-Range changed:

listed as 4-275-1E

changed to NW NW NE, 4-275-1E

Other changes: Initial statements: \_\_\_\_\_

Changed to: \_\_\_\_\_

Comments: \_\_\_\_\_

verification method: well address on form, legal description, city map,  
and Wichita East 1:24,000 topo. map. initials: ERA date: 10/17/2001

submitted by: Kansas Geological Survey, Data Resources Library, 1930 Constant Ave., Lawrence, KS 66047-3726  
to: Kansas Dept of Health & Environment Bureau of Water Industrial Programs, Bldg 283, Forbes Field, KS 66620

USE TYPEWRITER OR BALL  
POINT PEN-PRESS FIRMLY,  
PRINT CLEARLY.

T	R	EW	sec 1/4	1/4	1/4	No.
---	---	----	---------	-----	-----	-----


WATER WELL RECORD  
KSA 82a-1201-1215

Kansas State Dept. Of Health  
(Water Well Contractors)  
Forbes-Bldg. 740  
Topeka, Kansas 66620

BILLED TO: Joe Wilson Pump & Well

1 Location of well:	County <b>Sedgwick</b>	Township name <b>Wichita</b>	Fraction	Section number <b>4</b>	Town number <b>27S</b>	Range number <b>1E</b>
---------------------	---------------------------	---------------------------------	----------	----------------------------	---------------------------	---------------------------

Distance and direction from nearest town or city: Street address of well location if in city:	<b>2811 North Ohio Wichita, Kansas</b>	3 Owner of well: Address:	<b>Vim Trailer Mfg. Inc. 2547 North Market Wichita, Kansas</b>
--	--	------------------------------	--

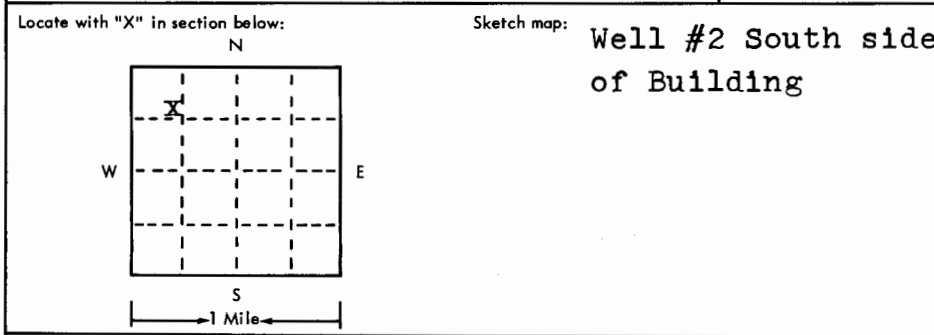

4 Well depth: 40 ft. Date of completion 1-25-75  
Well diameter 16 in.

5  Cable tool  Rotary  Driven  Dug  
 Hollow rod  Jetted  Bored  Reverse rotary

6 Use:  Domestic  Public supply  Industry  
 Irrigation  Air conditioning  Commercial  
 Test well  see #16

7 Casing: Material PVC Height: above/below  
Threaded  Welded  Surface 12 in.  
Diam. 10 in. to 40 ft. depth Weight \_\_\_\_\_ lbs./ft. \_\_\_\_  
\_\_\_\_\_ in. to \_\_\_\_\_ ft. depth Drive shoe?  Yes  No

2	Type and color of material	From	To
	Dirt and clay	0	18
	Medium sand	18	20
	Coarse sand	20	25
	Coarse sand and fine gravel	25	40

8 Screen: Manufacturer Certain-Teed  
Type PVC Dia. 10"  
Slot/gauze .070 Length 15'  
Set between 25 ft. and 40 ft. \_\_\_\_  
Fittings: Gravel pack  Yes  No Size range of material 1/4 - 1/8"

9 Static water level: 20 ft. below land surface Date 1-25-75

10 Pumping level below land surfaces:  
\_\_\_\_\_ ft. after \_\_\_\_\_ hrs. pumping \_\_\_\_\_ g.p.m.  
\_\_\_\_\_ ft. after \_\_\_\_\_ hrs. pumping \_\_\_\_\_ g.p.m.  
Estimated maximum yield \_\_\_\_\_ g.p.m.

11 Water sample submitted:  
 Yes  No Date \_\_\_\_\_

12 Well head completion: capped  
 Pitless adapter 12  Inches above grade

13 Well grouted?  Yes  No  
 Neat cement  Bentonite  \_\_\_\_\_  
Depth: From \_\_\_\_\_ ft. to 12 ft.

14 Nearest source of possible contamination: NONE  
ft. \_\_\_\_\_ Direction \_\_\_\_\_ Type \_\_\_\_\_  
Well disinfected upon completion?  Yes  No

15 Pump:  Not installed  
Manufacturer's name \_\_\_\_\_  
Model number \_\_\_\_\_ HP \_\_\_\_\_ Volts \_\_\_\_\_  
Length of drop pipe \_\_\_\_\_ ft. capacity \_\_\_\_\_ g.p.m.  
Type:  Submersible  Turbine  
 Jet  Reciprocating  
 Centrifugal  Other

16 Remarks: elevation Level ground  
**\* Water to be used to fill tank trucks and air conditioning use.**  
Topography:  
 Hill  
 Slope **Well is not going to be used for drinking water; usage is to fill tank truck, and air conditioning.**  
 Upland  
 Valley

17 Water well contractor's certification:  
This well was drilled under my jurisdiction and this report is true to the best of my knowledge and belief.  
**Harp Well & Pump Serv. 236**  
Business name Wichita, Kansas License No. 67209  
Address \_\_\_\_\_  
Signed Mary Arnold Date 2-26-75  
Authorized representative