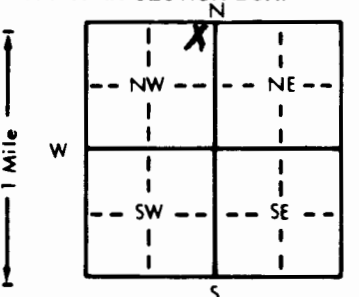


1 LOCATION OF WATER WELL:		Fraction	Section Number		Township Number	Range Number
County: Sedgwick		NE 1/4 NE 1/4 NW 1/4	5		T 27 S	R 1E E/W
Distance and direction from nearest town or city street address of well if located within city?						
2801 N. Mascott Wichita, Ks.						
2 WATER WELL OWNER: Mable Alice Muth Estates						
RR#, St. Address, Box #: c/o 1st National Bank P.O. Box 1						
City, State, ZIP Code: Wichita, Ks. 67201						
Board of Agriculture, Division of Water Resources						
Application Number:						
3 LOCATE WELL'S LOCATION WITH AN "X" IN SECTION BOX:						
		4 DEPTH OF Completed ^{plugged} WELL: 18 ft. ELEVATION:				
Depth(s) Groundwater Encountered 1. ft. 2. ft. 3. ft.		WELL'S STATIC WATER LEVEL 15 ft. below land surface measured on mo/day/yr 7-25-90				
Pump test data: Well water was ft. after hours pumping gpm		Est. Yield gpm: Well water was ft. after hours pumping gpm				
Bore Hole Diameter in. to ft. and in. to ft.		WELL WATER TO BE USED AS:				
1 Domestic 3 Feedlot 6 Oil field water supply 9 Dewatering 12 Other (Specify below)		5 Public water supply 8 Air conditioning 11 Injection well				
2 Irrigation 4 Industrial 7 Lawn and garden only 10 Monitoring well		Was a chemical/bacteriological sample submitted to Department? Yes No X; If yes, mo/day/yr sample was submitted				
5 TYPE OF BLANK CASING USED:		CASING JOINTS: Glued Clamped				
1 Steel 3 RMP (SR)		Welded				
2 PVC 4 ABS		Threaded				
Blank casing diameter in. to ft. Dia in. to ft. Dia in. to ft.		Casing height above land surface in. weight lbs./ft. Wall thickness or gauge No.				
TYPE OF SCREEN OR PERFORATION MATERIAL:		7 PVC 10 Asbestos-cement				
1 Steel 3 Stainless steel 5 Fiberglass 8 RMP (SR) 11 Other (specify)		2 Brass 4 Galvanized steel 6 Concrete tile 9 ABS 12 None used (open hole)				
SCREEN OR PERFORATION OPENINGS ARE:		5 Gauzed wrapped 8 Saw cut 11 None (open hole)				
1 Continuous slot 3 Mill slot 6 Wire wrapped 9 Drilled holes		2 Louvered shutter 4 Key punched 7 Torch cut 10 Other (specify)				
SCREEN-PERFORATED INTERVALS: From ft. to ft. From ft. to ft. From ft. to ft.		GRAVEL PACK INTERVALS: From ft. to ft. From ft. to ft. From ft. to ft.				
6 GROUT MATERIAL:		1 Neat cement 2 Cement grout 3 Bentonite 4 Other				
Grout Intervals: From ft. to ft. From ft. to ft. From ft. to ft.		What is the nearest source of possible contamination:				
1 Septic tank 4 Lateral lines 7 Pit privy 10 Livestock pens 14 Abandoned water well		2 Sewer lines 5 Cess pool 8 Sewage lagoon 11 Fuel storage 15 Oil well/Gas well				
3 Watertight sewer lines 6 Seepage pit 9 Feedyard 12 Fertilizer storage 16 Other (specify below)		13 Insecticide storage				
Direction from well? So.		How many feet? 30				
FROM TO LITHOLOGIC LOG		FROM TO PLUGGING INTERVALS				
		0 6		concrete grout		
		6 15		Bentonite hole plug		
		15 18		Chlorinated sand		
7 CONTRACTOR'S OR LANDOWNER'S CERTIFICATION: This water well was (1) constructed, (2) reconstructed, or (3) plugged under my jurisdiction and was completed on (mo/day/year) 7-25-90 and this record is true to the best of my knowledge and belief. Kansas						
Water Well Contractor's License No. 236 This Water Well Record was completed on (mo/day/yr) 10-15-90						
under the business name of Harp Well and Pump Service, Inc. by (signature) Mary Arnold						
INSTRUCTIONS: Use typewriter or ball point pen. PLEASE PRESS FIRMLY and PRINT clearly. Please fill in blanks, underline or circle the correct answers. Send top three copies to Kansas Department of Health and Environment, Bureau of Water, Topeka, Kansas 66620-7320. Telephone: 913-296-5545. Send one to WATER WELL OWNER and retain one for your records.						