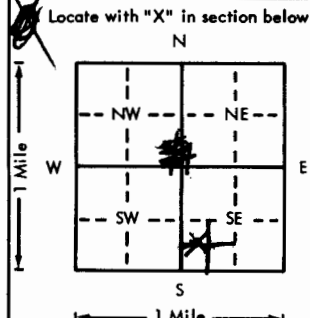


USE TYPEWRITER OR BALL
POINT PEN-PRESS FIRMLY,
PRINT CLEARLY.

WATER WELL RECORD
KSA 82a-1201-1215

Kansas Department of Health and
Environment-Division of Environment
(Water well Contractors)
Topeka, Kansas 66620

SE SW SW SE

1. Location of well: County <u>Sedgewick</u> Section <u>14 SE 1/4 SE 1/4</u> Section number <u>7</u> Township number <u>T 27</u> Range number <u>S R 1 E</u> E/W	
2. Distance and direction from nearest town or city: Street address of well location if in city: <u>1811 McKee</u>	
3. Owner of well: <u>D. Bryant</u> R.R. or street: <u>1811 McKee</u> City, state, zip code: <u>Wichita Kansas</u>	
Locate with "X" in section below: Sketch map: 	
5. Type and color of material	
From To	
Top soil & Sand 0' 10'	
1 1/4" steel pipe - Sand 10' 20'	
1 1/4" well point - Sand 20' 25'	
6. Bore hole dia. <u>5</u> in. Completion date <u>4-19-76</u> Well depth <u>25</u> ft.	
7. Cable tool <input type="checkbox"/> Rotary <input checked="" type="checkbox"/> Driven <input type="checkbox"/> Dug <input type="checkbox"/> Hollow rod <input type="checkbox"/> Jetted <input checked="" type="checkbox"/> Bored <input type="checkbox"/> Reverse rotary	
8. Use: Domestic <input type="checkbox"/> Public supply <input type="checkbox"/> Industry <input type="checkbox"/> Irrigation <input type="checkbox"/> Air conditioning <input type="checkbox"/> Stock <input checked="" type="checkbox"/> Lawn <input type="checkbox"/> Oil field water <input type="checkbox"/> Other	
9. Casing: Material <u>Steel</u> Height: Above or below Threaded <input checked="" type="checkbox"/> Welded <input type="checkbox"/> Surface <u>12</u> in. RMP <input type="checkbox"/> PVC <input type="checkbox"/> Weight <u>2.28</u> lbs./ft. Dia. <u>5</u> in. to <u>10</u> ft. depth Wall thickness: inches or Dia. <u>4.5</u> in. to <u>25</u> ft. depth gage No. <u></u>	
10. Screen: Manufacturer's name <u>Johnson</u> Type <u>5001</u> Dia. <u>1.25"</u> Slot/gauze <u>#10</u> Length <u>5'</u> Set between <u>20</u> ft. and <u>25</u> ft. Gravel pack? <input type="checkbox"/> Size range of material <u></u>	
11. Static water level: <u>14</u> ft. below land surface Date <u></u> mo./day/yr.	
12. Pumping level below land surfaces: <u>14</u> ft. after <u>1</u> hrs. pumping <u>10</u> g.p.m. <u></u> ft. after <u></u> hrs. pumping <u></u> g.p.m. Estimated maximum yield <u>25</u> g.p.m.	
13. Water sample submitted: <u>X</u> Yes <u></u> No Date <u>4-19-76</u> mo./day/yr.	
14. Well head completion: <u>12</u> Pitless adapter <u>12</u> inches above grade	
15. Well grouted? <input checked="" type="checkbox"/> With: Neat cement <input checked="" type="checkbox"/> Bentonite <input checked="" type="checkbox"/> Grout Depth: From <u>0</u> ft. to <u>10</u> ft.	
16. Nearest source of possible contamination: ft. <u>60</u> Direction <u>West</u> Type <u>River</u> Well disinfected upon completion? <u>X</u> Yes <u></u> No	
17. Pump: <input checked="" type="checkbox"/> Not installed Manufacturer's name <u></u> Model number <u></u> HP <u></u> Volts <u></u> Length of drop pipe <u></u> ft. capacity <u></u> g.p.m. Type: <input type="checkbox"/> Submersible <input type="checkbox"/> Turbine <input type="checkbox"/> Jet <input type="checkbox"/> Reciprocating <input type="checkbox"/> Centrifugal <input type="checkbox"/> Other	
(Use a second sheet if needed)	
18. Elevation:	19. Remarks:
Topography: <input type="checkbox"/> Hill <input type="checkbox"/> Slope <input type="checkbox"/> Upland <input checked="" type="checkbox"/> Valley	
20. Water well contractor's certification: This well was drilled under my jurisdiction and this report is true to the best of my knowledge and belief. <u>2157 Electric</u> <u>129</u> Business name <u>512 W. 2157</u> License No. <u></u> Address <u>Johns Hemo</u> <u>5-7-76</u> Signed <u></u> Date <u></u> Authorized representative	

Forward the white, blue and pink copies to the Department of Health and Environment

Form WWC-5