

1	LOCATION OF WATER WELL:	Fraction	Section Number	Township Number	Range Number
County:	Sedgwick	NE ¼ NE NW ¼ SW ¼	7	T 27 S	R 1 E EW

Distance and direction from nearest town or city street address of well if located within city?


1751 No. Athenian Wichita, Ks.

2 WATER WELL OWNER: Edward Jones
RR#, St. Address, Box # : 1751 No. Athenian
City, State, ZIP Code : Wichita, Kansas

Board of Agriculture, Division of Water Resources
Application Number:

3 LOCATE WELL'S LOCATION WITH AN "X" IN SECTION BOX:

4. DEPTH OF COMPLETED WELL.....40..... ft. ELEVATION:

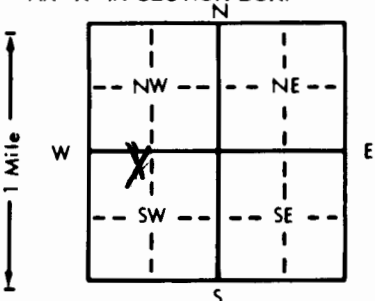

4. DEPTH OF COMPLETED WELL.....40..... ft. ELEVATION:

WELL'S STATIC WATER LEVEL ... 15 ... ft. below land surface measured on mo/day/yr ... 7-13-84

Pump test data: Well water was ft. after hours pumping gpm

Est. Yield gpm: Well water was ft. after hours pumping gpm
Bore Hole Diameter in. to ft. and in. to ft.

WELL WATER TO BE USED AS: 5 Public water supply 8 Air conditioning 11 Injection well

1 <u>Domestic</u>	3 Feedlot	6 Oil field water supply	9 Dewatering	12 Other (Specify below)
2 <u>Irrigation</u>	4 Industrial	7 Lawn and garden only	10 Observation well	

Was a chemical/bacteriological sample submitted to Department? Yes.....No...**X**.....; If yes, mo/day/yr sample was sub

5	TYPE OF BLANK CASING USED:	5 Wrought iron	8 Concrete tile	CASING JOINTS: Glued	✓	Clamped
---	----------------------------	----------------	-----------------	----------------------	---	---------

1 Steel	3 RMP (SR)	6 Asbestos-Cement	9 Other (specify below)	Welded
2 PVC	4 ABS	7 Fiberglass	Cer-Mac styrene SDR-26	Threaded

Blank casing diameter . . . 5 . . . in. to . . . 20 . . . ft., Dia . . . in. to . . . ft., Dia . . . in. to . . . ft.

Casing height above land surface. 12 in., weight 1.59 lbs./ft. Wall thickness or gauge No. 203

TYPE OF SCREEN OR PERFORATION MATERIAL: 7 PVC 10 Asbestos-cement

1 Steel	3 Stainless steel	5 Fiberglass	8 RMP (SR)	11 Other (specify)
2 Brass	4 Galvanized steel	6 Concrete tile	9 ABS	12 None used (open hole)

SCREEN OR PERFORATION OPENINGS ARE:

1 Continuous slot	2 Mill slot	5 Gauzed wrapped	8 Saw cut	11 None (open hole)
		6 Wire wrapped	9 Drilled holes	

1 Continuous slot	3 Mill slot	6 Wire wrapped	9 Drilled holes
2 Louvered shutter	4 Key punched	7 Torch cut	10 Other (specify)

SCREEN-PERFORATED INTERVALS: From 20 ft. to 40 ft., From ft. to ft.
From ft. to ft., From ft. to ft.

GRAVEL PACK INTERVALS: From 14 ft. to 40 ft., From ft. to ft.

	From	ft. to	ft., From	ft. to	ft.
SECTION INTERIM					

8) GROUT MATERIAL: 1 Neat cement 2 Cement grout 3 Bentonite 4 Other
Grout Intervals: From 4 ft. to 14 ft. From ft. to ft. From ft. to ft.

What is the nearest source of possible contamination: 10 Livestock pens 14 Abandoned water well

1 Septic tank	4 Lateral lines	7 Pit privy	11 Fuel storage	15 Oil well/Gas well
2 Sewer lines	5 Cess pool	8 Sewage lagoon	12 Fertilizer storage	16 Other (specify below)

3 Watertight sewer lines

Direction from well?		South		How many feet?		20	
FROM	TO	LITHOLOGIC LOG		FROM	TO	LITHOLOGIC LOG	

0	3 @ Topsoil			
---	-------------	--	--	--

3	19 07	Fine Sand			
10	25 08	Medium Sand			

19	35	30 Medium Sand			
35	40	09 Coarse Sand			

[illegible][illegible][illegible][illegible][illegible]

--	--	--	--	--	--

7	CONTRACTOR'S OR LANDOWNER'S CERTIFICATION: This water well was (1) constructed, (2) reconstructed, or (3) plugged under my jurisdiction and was									
---	---	--	--	--	--	--	--	--	--	--

7-13-84 and this record is true to the best of my knowledge and belief Kansas

Water Well Contractor's License No. 236 This Water Well Record was completed on (mo/day/yr) 10-31-87
under the business name of Harp Well & Pump Service, Inc. by (signature) James J. Harp

INSTRUCTIONS: Use typewriter or ball point pen, **PLEASE PRESS FIRMLY and PRINT** clearly. Please fill in blanks, underline of circle the correct answers. Send top

three copies to Kansas Department of Health and Environment, Division of Environment, Environmental Geology Section, Topeka, KS 66620. Send one to WATER WELL OWNER and retain one for your records.
