WATER WELL RECORD Form WWC-5 KSA 82a-1212

1 LOCATION OF WATER WELL: County: Sedgwick | Fraction: NW ¼ SW ¼ NW ¼ | Section Number: 7 | Township Number: T 27 S | Range Number: R 1 (E/W)

Distance and direction from nearest town or city street address of well if located within city?
1902 N. Sedgwick

2 WATER WELL OWNER: Gary Reynolds
RR#, St. Address, Box # : 1902 N. Sedgwick
City, State, ZIP Code : Wichita, Kansas 67203

Board of Agriculture, Division of Water Resources Application Number: None

3 LOCATE WELL'S LOCATION WITH AN "X" IN SECTION BOX:

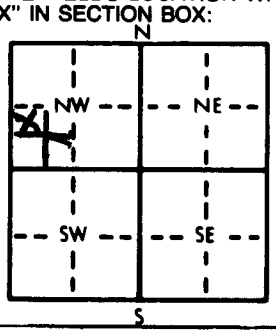

4 DEPTH OF COMPLETED WELL 40 ft. ELEVATION: 1300 ft.
Depth(s) Groundwater Encountered 1. 20 ft. 2. ft. 3. ft.
WELL'S STATIC WATER LEVEL 20 ft. below land surface measured on mo/day/yr 3-1-88
Pump test data: Well water was ft. after hours pumping gpm
Est. Yield 75 gpm: Well water was ft. after hours pumping gpm
Bore Hole Diameter 9 in. to 20 ft., and in. to ft.
WELL WATER TO BE USED AS: 1 Domestic 2 Irrigation 3 Feedlot 4 Industrial 5 Public water supply 6 Oil field water supply (7) Lawn and garden only 8 Air conditioning 9 Dewatering 10 Observation well 11 Injection well 12 Other (Specify below)
Was a chemical/bacteriological sample submitted to Department? Yes ..... No XXX; If yes, mo/day/yr sample was submitted
Water Well Disinfected? Yes No XXX

5 TYPE OF BLANK CASING USED: (1) Steel (2) PVC (3) RMP (SR) (4) ABS 5 Wrought iron 6 Asbestos-Cement 7 Fiberglass 8 Concrete tile 9 Other (specify below)
CASING JOINTS: Glued XXX Clamped Welded Threaded
Blank casing diameter 5.56 in. to 30 ft., Dia in. to ft., Dia in. to ft.
Casing height above land surface 12 in., weight 1.59 lbs./ft. Wall thickness or gauge No. SDR26

TYPE OF SCREEN OR PERFORATION MATERIAL: 1 Steel 2 Brass 3 Stainless steel 4 Galvanized steel 5 Fiberglass 6 Concrete tile 7 PVC (8) RMP (SR) 9 ABS 10 Asbestos-cement 11 Other (specify) 12 None used (open hole)
SCREEN OR PERFORATION OPENINGS ARE: 1 Continuous slot 2 Louvered shutter (3) Mill slot 4 Key punched 5 Gauzed wrapped 6 Wire wrapped 7 Torch cut 8 Saw cut 9 Drilled holes 10 Other (specify) 11 None (open hole)
SCREEN-PERFORATED INTERVALS: From 30 ft. to 40 ft., From ft. to ft.
From ft. to ft., From ft. to ft.
GRAVEL PACK INTERVALS: From ft. to ft., From ft. to ft.
From ft. to ft., From ft. to ft.

6 GROUT MATERIAL: 1 Neat cement (2) Cement grout 3 Bentonite 4 Other
Grout Intervals: From 0 ft. to 20 ft., From ft. to ft., From ft. to ft.
What is the nearest source of possible contamination: 1 Septic tank 2 Sewer lines (3) Watertight sewer lines 4 Lateral lines 5 Cess pool 6 Seepage pit 7 Pit privy 8 Sewage lagoon 9 Feedyard 10 Livestock pens 11 Fuel storage 12 Fertilizer storage 13 Insecticide storage 14 Abandoned water well 15 Oil well/Gas well 16 Other (specify below)
Direction from well? North How many feet? 30

FROM	TO	LITHOLOGIC LOG	FROM	TO	LITHOLOGIC LOG
0	8	Top soil			
8	21	Fine tan sand			
21	40	Coarse tan sand			

7 CONTRACTOR'S OR LANDOWNER'S CERTIFICATION: This water well was (1) constructed, (2) reconstructed, or (3) plugged under my jurisdiction and was completed on (mo/day/year) 3-1-88 and this record is true to the best of my knowledge and belief. Kansas Water Well Contractor's License No. [redacted] 472 This Water Well Record was completed on (mo/day/yr) 3-21-88 under the business name of Bearden Pump & Well by (signature) David R. Bea

INSTRUCTIONS: Use typewriter or ball point pen. *PLEASE PRESS FIRMLY* and *PRINT* clearly. Please fill in blanks, underline or circle the correct answers. Send top three copies to Kansas Department of Health and Environment, Office of Oil Field and Environmental Geology, Regulation and Permitting Section, Topeka, Kansas 66620-7500, Telephone: 913-862-9360. Send one to WATER WELL OWNER and retain one for your records.

OFFICE USE ONLY T H E/W SEC. ¼ ¼ ¼