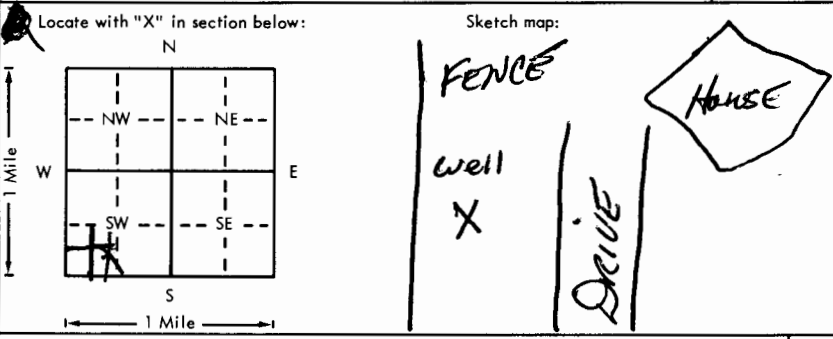


USE TYPEWRITER OR BALL
POINT PEN-PRESS FIRMLY,
PRINT CLEARLY.

WATER WELL RECORD
KSA 82a-1201-1215

Kansas Department of Health and
Environment-Division of Environment
(Water well Contractors)
Topeka, Kansas 66620

1. Location of well: County <u>Sedgwick</u> Section <u>SE-SW-SW</u> Township number <u>27</u> Range number <u>1</u>	
2. Distance and direction from nearest town or city: <u>WICHITA</u> Street address of well location if in city: <u>1407 BURNS</u>	
3. Owner of well: <u>ROBERT DYER</u> R.R. or street: <u>1407 BURNS</u> City, state, zip code: <u>WICHITA, KS.</u>	
4. Locate with "X" in section below: Sketch map: 	
6. Bore hole dia. <u>11</u> in. Completion date <u>7-30-78</u> Well depth <u>30</u> ft.	
7. <input type="checkbox"/> Cable tool <input type="checkbox"/> Rotary <input type="checkbox"/> Driven <input type="checkbox"/> Dug <input type="checkbox"/> Hollow rod <input checked="" type="checkbox"/> Jetted <input checked="" type="checkbox"/> Bored <input type="checkbox"/> Reverse rotary	
8. Use: <input type="checkbox"/> Domestic <input type="checkbox"/> Public supply <input type="checkbox"/> Industry <input type="checkbox"/> Irrigation <input type="checkbox"/> Air conditioning <input type="checkbox"/> Stock <input checked="" type="checkbox"/> Lawn <input type="checkbox"/> Oil field water <input type="checkbox"/> Other	
9. Casing: Material <u>PVC</u> Height: Above or below <input type="checkbox"/> Threading <input type="checkbox"/> Welded <input type="checkbox"/> Surface <u>12</u> in. RMP <input type="checkbox"/> PVC <input checked="" type="checkbox"/> Weight <u>2.752</u> lbs./ft. Dia. <u>5</u> in. to <u>30</u> ft. depth Wall thickness: inches or Dia. <u>5</u> in. to <u>30</u> ft. depth gage No. <u>252</u>	
10. Screen: Manufacturer's name <u>MODERN</u> Type <u>PVC</u> Dia. <u>5.563</u> Slot/gauze <u>0.25</u> Length <u>5'</u> Set between <u>25</u> ft. and <u>30</u> ft. Gravel pack? <u>NO</u> Size range of material <u>3</u>	
11. Static water level: <u>15</u> ft. below land surface Date <u>7-30-78</u> mo./day/yr.	
12. Pumping level below land surfaces: <u>15</u> ft. after <u>1</u> hrs. pumping <u>25</u> g.p.m. <u>50</u> ft. after <u> </u> hrs. pumping <u> </u> g.p.m. Estimated maximum yield <u>50</u> g.p.m.	
13. Water sample submitted: <u>NO</u> Yes <u>NO</u> Date <u>7-30-78</u> mo./day/yr.	
14. Well head completion: <u>12</u> Pitless adapter <u>12</u> Inches above grade	
15. Well grouted? <u>YES</u> With: <u>Neat cement</u> <input checked="" type="checkbox"/> Bentonite <input type="checkbox"/> Concrete Depth: From <u>0</u> ft. to <u>10</u> ft.	
16. Nearest source of possible contamination: <u>60</u> ft. Direction <u>NE</u> Type <u>SEWER</u> Well disinfected upon completion? <u>YES</u> Yes <u>NO</u> No	
17. Pump: <u>Not installed</u> Manufacturer's name <u>Emerson</u> Model number <u>HP 7552</u> HP <u>3/4</u> Volts <u>230</u> Length of drop pipe <u>25</u> ft. capacity <u>20</u> g.p.m. Type: <input checked="" type="checkbox"/> Submersible <input type="checkbox"/> Turbine <input type="checkbox"/> Jet <input type="checkbox"/> Reciprocating <input type="checkbox"/> Centrifugal <input type="checkbox"/> Other	
(Use a second sheet if needed)	
18. Elevation: Topography: <input type="checkbox"/> Hill <input type="checkbox"/> Slope <input checked="" type="checkbox"/> Upland <input type="checkbox"/> Valley	19. Remarks:
20. Water well contractor's certification: This well was drilled under my jurisdiction and this report is true to the best of my knowledge and belief. <u>21st Electric Co.</u> <u>129</u> Business name <u>512 W. 21st Wichita</u> License No. <u> </u> Address <u> </u> Signed <u>J. Harris</u> Date <u>8-2-78</u> Authorized representative	

Forward the white, blue and pink copies to the Department of Health and Environment

Form WWC-5