

NW-2

1 LOCATION OF WATER WELL: County: <u>Sedgewick</u>	Fraction <u>NW</u> $\frac{1}{4}$ <u>SW</u> $\frac{1}{4}$ <u>NW</u> $\frac{1}{4}$	Section Number <u>9</u>	Township Number T <u>27</u> S	Range Number R <u>1</u> <u>E/W</u>
---	---	----------------------------	----------------------------------	---------------------------------------

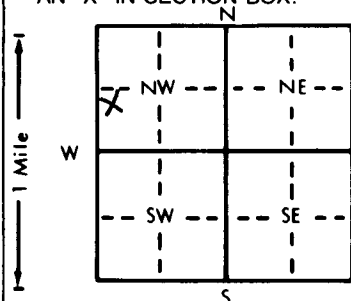
Distance and direction from nearest town or city street address of well if located within city?

400 E 18th, Wichita, KS2 WATER WELL OWNER: Krehbiel PropertiesRR#, St. Address, Box #: 400 E 18thCity, State, ZIP Code: Wichita, KS

Board of Agriculture, Division of Water Resources

Application Number:

3 LOCATE WELL'S LOCATION WITH AN "X" IN SECTION BOX:

4 DEPTH OF COMPLETED WELL: 27.5 ft. ELEVATION:Depth(s) Groundwater Encountered 1. 18 ft. 2. ft. 3. ft.WELL'S STATIC WATER LEVEL 18 ft. below land surface measured on mo/day/yr 6/4/09

Pump test data: Well water was ft. after hours pumping gpm

Est. Yield gpm: Well water was ft. after hours pumping gpm

Bore Hole Diameter: 7.25 in. to ft., and in. to ft.

WELL WATER TO BE USED AS: 5 Public water supply 8 Air conditioning 11 Injection well

1 Domestic 3 Feedlot 6 Oil field water supply 9 Dewatering 12 Other (Specify below)

2 Irrigation 4 Industrial 7 Lawn and garden only 10 Monitoring wellWas a chemical/bacteriological sample submitted to Department? Yes No X; If yes, mo/day/yr sample was submittedWater Well Disinfected? Yes No X

5 TYPE OF BLANK CASING USED:

5 Wrought iron

8 Concrete tile

CASING JOINTS: Glued Clamped

1 Steel

3 RMP (SR)

6 Asbestos-Cement

9 Other (specify below)

Welded

2 PVC

4 ABS

7 Fiberglass

Threaded XBlank casing diameter 2 in. to 13 ft., Dia. in. to ft., Dia. in. to ft.Casing height above land surface 0 in., weight lbs./ft. Wall thickness or gauge No. Sch. 40

TYPE OF SCREEN OR PERFORATION MATERIAL:

1 Steel

3 Stainless steel

5 Fiberglass

7 PVC

10 Asbestos-cement

2 Brass

4 Galvanized steel

6 Concrete tile

9 ABS

11 Other (specify)

12 None used (open hole)

SCREEN OR PERFORATION OPENINGS ARE:

1 Continuous slot

3 Mill slot

5 Gauzed wrapped

8 Saw cut

11 None (open hole)

2 Louvered shutter

4 Key punched

6 Wire wrapped

9 Drilled holes

7 Torch cut

10 Other (specify)

SCREEN-PERFORATED INTERVALS: From 13 ft. to 27.5 ft., From ft. to ft.

From ft. to ft., From ft. to ft.

GRAVEL PACK INTERVALS: From ft. to ft., From ft. to ft.

From ft. to ft., From ft. to ft.

6 GROUT MATERIAL:

1 Neat cement

2 Cement grout

3 Bentonite

4 OtherVolclay GroutGrout Intervals: From 0 ft. to 8 ft., From ft. to ft., From ft. to ft.

What is the nearest source of possible contamination:

1 Septic tank

4 Lateral lines

7 Pit privy

10 Livestock pens

14 Abandoned water well

2 Sewer lines

5 Cess pool

8 Sewage lagoon

1 Fuel storage

15 Oil well/Gas well

3 Watertight sewer lines

6 Seepage pit

9 Feedyard

12 Fertilizer storage

16 Other (specify below)

13 Insecticide storage

Direction from well? SouthwestHow many feet? 160

FROM	TO	LITHOLOGIC LOG	FROM	TO	PLUGGING INTERVALS
0	1	Black gravel			
1	5	Brown sandy clay			
5	10	Brown med grained sand			
10	27.5	Brown med-coarse sand			
grout! casing height variances granted.					

7 CONTRACTOR'S OR LANDOWNER'S CERTIFICATION: This water well was (1) constructed, (2) reconstructed, or (3) plugged under my jurisdiction and was completed on (mo/day/year) 6/6/09 and this record is true to the best of my knowledge and belief. KansasWater Well Contractor's License No. 517-496 This Water Well Record was completed on (mo/day/yr) 9/6/09under the business name of Groundwater Tech, Inc.by (signature) Banjamin D. ...