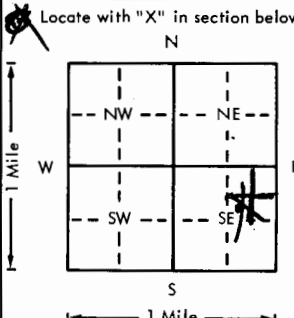


USE TYPEWRITER OR BALL
POINT PEN-PRESS FIRMLY,
PRINT CLEARLY.

WATER WELL RECORD
KSA 82a-1201-1215

Kansas Department of Health and
Environment-Division of Environment
(Water well Contractors)
Topeka, Kansas 66620

1. Location of well:		County <u>Sedgwick</u> <u>SE 1/4 SW-NE-SE 1/4</u>	Section number <u>9</u>	Township number <u>T 27</u>	Range number <u>S 1 R 1</u>
2. Distance and direction from nearest town or city: <u>WICHITA</u>		3. Owner of well: <u>Doss Townsend</u>			
Street address of well location if in city: <u>1601 New York</u>		R.R. or street: <u>1601 New York</u>			
City, state, zip code: <u>WICHITA, KS.</u>					
Locate with "X" in section below:		Sketch map: <u>House</u> <u>Garage</u> <u>well</u>		6. Bore hole dia. <u>11</u> in. Completion date <u>7-25-78</u>	
				Well depth <u>32</u> ft.	
5. Type and color of material		From	To	7. Cable tool <input type="checkbox"/> Rotary <input type="checkbox"/> Driven <input type="checkbox"/> Dug <input type="checkbox"/> Hollow rod <input type="checkbox"/> Jetted <input checked="" type="checkbox"/> Bored <input type="checkbox"/> Reverse rotary	
<u>top Soil</u>		<u>0</u>	<u>10</u>	8. Use: <input type="checkbox"/> Domestic <input type="checkbox"/> Public supply <input type="checkbox"/> Industry <input type="checkbox"/> Irrigation <input type="checkbox"/> Air conditioning <input type="checkbox"/> Stock <input checked="" type="checkbox"/> Lawn <input type="checkbox"/> Oil field water <input type="checkbox"/> Other	
<u>SAND</u>		<u>11</u>	<u>15</u>	9. Casing: Material <u>PVC</u> Height: Above or below <u>12</u> in.	
<u>GRAVEL</u>		<u>15</u>	<u>25</u>	Threading <u>Welded</u> Surface <u>12</u> in. RMP <u>PVC</u> Weight <u>2758</u> lbs./ft.	
				Dia. <u>5</u> in. to <u>32</u> ft. depth Wall Thickness: inches or <u>1/2</u> Dia. in. to <u>32</u> ft. depth gage No. <u>258</u>	
				10. Screens: Manufacturer's name <u>Modern Pipe Co.</u>	
				Type <u>PVC</u> Dia. <u>5.563</u>	
				Slot/gauze <u>.025</u> Length <u>5</u>	
				Set between <u>27</u> ft. and <u>32</u> ft.	
				Gravel pack? <u>NO</u> Size range of material	
				11. Static water level: <u>20</u> ft. below land surface Date <u>7-25-78</u> mo./day/yr.	
				12. Pumping level below land surfaces: <u>20</u> ft. after <u>1</u> hrs. pumping <u>20</u> g.p.m.	
				ft. after <u> </u> hrs. pumping <u> </u> g.p.m.	
				Estimated maximum yield <u>50</u> g.p.m.	
				13. Water sample submitted: <u> </u> mo./day/yr.	
				Yes <input type="checkbox"/> No <input checked="" type="checkbox"/> Date <u> </u>	
				14. Well head completion: <u>12</u> inches above grade	
				Pitless adapter <u> </u>	
				15. Well grouted? <u>Yes</u>	
				With: <u>Neat cement</u> Bentonite <u> </u> Concrete <u> </u>	
				Depth: From <u>0</u> ft. to <u>10</u> ft.	
				16. Nearest source of possible contamination: <u>60</u> ft. Direction <u>E</u> Type <u>SEWER</u>	
				Well disinfected upon completion? <u>Yes</u> <input checked="" type="checkbox"/> No <input type="checkbox"/>	
				17. Pump: <u> </u> Not installed	
				Manufacturer's name <u>Dempster</u>	
				Model number <u> </u> HP <u>3/4</u> Volts <u>220</u>	
				Length of drop pipe <u>25</u> ft. capacity <u>27</u> g.p.m.	
				Type: <input checked="" type="checkbox"/> Submersible <input type="checkbox"/> Turbine <input type="checkbox"/> Jet <input type="checkbox"/> Reciprocating <input type="checkbox"/> Centrifugal <input type="checkbox"/> Other	
18. Elevation:		20. Water well contractor's certification:			
Topography: <input type="checkbox"/> Hill <input type="checkbox"/> Slope <input type="checkbox"/> Upland <input checked="" type="checkbox"/> Valley		This well was drilled under my jurisdiction and this report is true to the best of my knowledge and belief.			
19. Remarks:		<u>2157 Electric</u> <u>129</u>			
		Business name <u>512 W. 2157</u> License No. <u> </u>			
		Address <u> </u>			
		Signed <u>J. Harris</u> Date <u>8-22-78</u>			
		Authorized representative			

Forward the white, blue and pink copies to the Department of Health and Environment

Form WWC-5