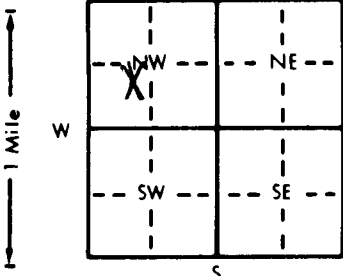


1 LOCATION OF WATER WELL:		Fraction		Section Number		Township Number		Range Number			
County: <u>Sedgwick</u>		NE 1/4 SW 1/4 NW 1/4		9		T 27 S		R 1 <u>EW</u>			
Distance and direction from nearest town or city street address of well if located within city? <u>518 E. 18th Street; Wichita Kansas</u>											
2 WATER WELL OWNER: <u>National By-Products</u>											
RR#, St. Address, Box # : <u>P.O. Box 615</u>					Board of Agriculture, Division of Water Resources						
City, State, ZIP Code : <u>Des Moines IA 50303</u>					Application Number:						
3 LOCATE WELL'S LOCATION WITH AN "X" IN SECTION BOX:		4 DEPTH OF COMPLETED WELL: <u>28.0'</u> ft. ELEVATION:									
<div style="text-align: center;"></div>		Depth(s) Groundwater Encountered 1. <u>17.0</u> ft. 2. ft. 3. ft.									
		WELL'S STATIC WATER LEVEL <u>17.70'</u> ft. below land surface measured on mo/day/yr <u>07-08-91</u>									
		Pump test data: Well water was ft. after hours pumping gpm									
		Est. Yield gpm: Well water was ft. after hours pumping gpm									
		Bore Hole Diameter <u>8"</u> in. to ft., and in. to ft.									
WELL WATER TO BE USED AS: 5 Public water supply 8 Air conditioning 11 Injection well											
1 Domestic 3 Feedlot 6 Oil field water supply 9 Dewatering 12 Other (Specify below)											
2 Irrigation 4 Industrial 7 Lawn and garden only 10 Monitoring well											
Was a chemical/bacteriological sample submitted to Department? Yes.....No <u>XX</u>; If yes, mo/day/yr sample was submitted											
Water Well Disinfected? Yes No <u>XXX</u>											
5 TYPE OF BLANK CASING USED:											
1 Steel 3 RMP (SR) 5 Wrought iron 8 Concrete tile CASING JOINTS: Glued Clamped											
2 PVC 4 ABS 6 Asbestos-Cement 9 Other (specify below) Welded											
7 Fiberglass Threaded. <u>Flush Jointed</u>											
Blank casing diameter <u>2"</u> in. to ft., Dia in. to ft., Dia in. to ft.											
Casing height above land surface in., weight <u>703</u> lbs./ft. Wall thickness or gauge No. <u>154</u>											
TYPE OF SCREEN OR PERFORATION MATERIAL:											
1 Steel 3 Stainless steel 5 Fiberglass 7 PVC 10 Asbestos-cement											
2 Brass 4 Galvanized steel 6 Concrete tile 8 RMP (SR) 11 Other (specify)											
9 ABS 12 None used (open hole)											
SCREEN OR PERFORATION OPENINGS ARE:											
1 Continuous slot 3 Mill slot 5 Gauzed wrapped 8 Saw cut 11 None (open hole)											
2 Louvered shutter 4 Key punched 6 Wire wrapped 9 Drilled holes											
7 Torch cut 10 Other (specify)											
SCREEN-PERFORATED INTERVALS: From <u>7.05'</u> ft. to <u>27.05'</u> ft., From ft. to ft.											
From ft. to ft., From ft. to ft.											
GRAVEL PACK INTERVALS: From <u>5.0'</u> ft. to <u>27.05'</u> ft., From ft. to ft.											
From ft. to ft., From ft. to ft.											
6 GROUT MATERIAL: 1 Neat cement 2 Cement grout 3 Bentonite 4 Other											
Grout Intervals: From <u>5.0</u> ft. to <u>5'</u> ft., From ft. to ft., From ft. to ft.											
What is the nearest source of possible contamination:											
1 Septic tank 4 Lateral lines 7 Pit privy 10 Livestock pens 14 Abandoned water well											
2 Sewer lines 5 Cess pool 8 Sewage lagoon 11 Fuel storage 15 Oil well/Gas well											
3 Watertight sewer lines 6 Seepage pit 9 Feedyard 12 Fertilizer storage 16 Other (specify below)											
13 Insecticide storage											
Direction from well? <u>West</u> How many feet? <u>75'</u>											
FROM		TO		LITHOLOGIC LOG		FROM		TO		PLUGGING INTERVALS	
0.0'		6"		Concrete							
6"		1.0'		Silty clay w/some sand							
1.0'		6.5'		Silty clay							
6.5'		8.0'		Concrete - fill							
8.0'		17.0'		Clayey sand							
17.0'		20.0'		Sandy clay							
20.0'		28.0'		Dirty poorly graded sand medium to fine w/ some silty clays							
7 CONTRACTOR'S OR LANDOWNER'S CERTIFICATION: This water well was (1) constructed, (2) reconstructed, or (3) plugged under my jurisdiction and was completed on (mo/day/year) <u>06-26-91</u> and this record is true to the best of my knowledge and belief. Kansas Water Well Contractor's License No. <u>531</u> This Water Well Record was completed on (mo/day/yr) <u>07-08-91</u> under the business name of <u>Geotechnical Services, Inc.</u> by (signature) <u>Allison Bassett</u>											
INSTRUCTIONS: Use typewriter or ball point pen. <u>PLEASE PRESS FIRMLY</u> and <u>PRINT</u> clearly. Please fill in blanks, underline or circle the correct answers. Send top three copies to Kansas Department of Health and Environment, Bureau of Water, Topeka, Kansas 66620-7320. Telephone: 913-296-5545. Send one to WATER WELL OWNER and retain one for your records.											

1180921006-22