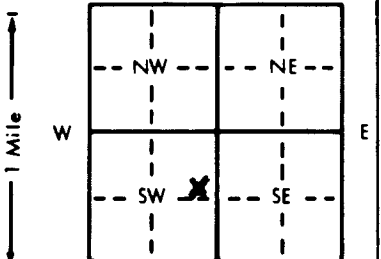


1 LOCATION OF WATER WELL:		Fraction	Section Number	Township Number	Range Number
County: <u>Sedgwick</u>		<u>SE 1/4 NE 1/4 SW 1/4</u>	<u>16</u>	<u>T 27 S</u>	<u>R 1 E</u>
Distance and direction from nearest town or city street address of well if located within city? <u>810 East Murdock Wichita, Kansas</u>					
2 WATER WELL OWNER: <u>HWS Technologies, Inc.</u>					
RR#, St. Address, Box # : <u>810 E. Murdock</u>					
City, State, ZIP Code : <u>Wichita, Kansas 67214</u>					
Board of Agriculture, Division of Water Resources					
Application Number:					
3 LOCATE WELL'S LOCATION WITH AN "X" IN SECTION BOX:		4 DEPTH OF COMPLETED WELL: <u>34</u> ft. ELEVATION: <u>13</u> ft.			
		WELL WATER TO BE USED AS: 5 Public water supply 8 Air conditioning 11 Injection well			
		1 Domestic 3 Feedlot 6 Oil field water supply 9 Dewatering 12 Other (Specify below)			
		2 Irrigation 4 Industrial 7 Lawn and garden only 10 Observation well			
		Was a chemical/bacteriological sample submitted to Department? Yes <u>X</u> No <u>X</u> If yes, mo/day/yr sample was submitted			
		Water Well Disinfected? Yes <u>X</u> No <u>X</u>			
5 TYPE OF BLANK CASING USED:					
1 Steel 3 RMP (SR) 5 Wrought iron 8 Concrete tile CASING JOINTS: Glued <u>X</u> Clamped <u>X</u>					
2 PVC 4 ABS 6 Asbestos-Cement 9 Other (specify below) Welded <u>X</u>					
7 Fiberglass Threaded <u>X</u>					
Casing height above land surface <u>12</u> in., weight <u>12</u> lbs./ft. Wall thickness or gauge No. <u>214</u>					
TYPE OF SCREEN OR PERFORATION MATERIAL:					
1 Steel 3 Stainless steel 5 Fiberglass 7 PVC 10 Asbestos-cement					
2 Brass 4 Galvanized steel 6 Concrete tile 8 RMP (SR) 11 Other (specify)					
3 Screened openings ARE: 4 Key punched 7 Torch cut 10 Other (specify)					
1 Continuous slot 3 Mill slot 4 Gauzed wrapped 8 Saw cut 11 None (open hole)					
2 Louvered shutter 4 Key punched 6 Wire wrapped 9 Drilled holes					
What is the nearest source of possible contamination:					
1 Septic tank 4 Lateral lines 7 Pit privy 10 Livestock pens 14 Abandoned water well					
2 Sewer lines 5 Cess pool 8 Sewage lagoon 11 Fuel storage 15 Oil well/Gas well					
3 Watertight sewer lines 6 Seepage pit 9 Feedyard 12 Fertilizer storage 16 Other (specify below)					
13 Insecticide storage					
Direction from well? <u>South</u> How many feet? <u>50</u>					
FROM TO LITHOLOGIC LOG FROM TO LITHOLOGIC LOG					
<u>0</u> <u>12</u> <u>Clay</u>					
<u>12</u> <u>36</u> <u>Sand & Fine Gravel</u>					
<u>36</u> <u>39</u> <u>Shale</u>					
7 CONTRACTOR'S OR LANDOWNER'S CERTIFICATION: This water well was (1) constructed, (2) reconstructed, or (3) plugged under my jurisdiction and was completed on (mo/day/year) <u>7-11-86</u> and this record is true to the best of my knowledge and belief. Kansas Water Well Contractor's License No. <u>102</u> This Water Well Record was completed on (mo/day/yr) <u>7-24-86</u> under the business name of <u>Layne-Western Co Wichita</u> by (signature) <u>[Signature]</u>					
INSTRUCTIONS: Use typewriter or ball point pen, PLEASE PRESS FIRMLY and PRINT clearly. Please fill in blanks, underline or circle the correct answers. Send top three copies to Kansas Department of Health and Environment, Division of Environment, Environmental Geology Section, Topeka, KS 66620. Send one to WATER WELL OWNER and retain one for your records.					