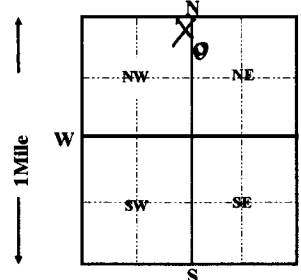


1 LOCATION OF WATER WELL: Sedgwick		FRACTION NW SW NW NE NE 1/4 NE 1/4 NW 1/4		Section Number 17		Township Number T 27 S		Range Number R 1E E/W	
Distance and direction from nearest town or city street address of well if located within city? 1307 Lewellen Wichita, Kansas									
2 WATER WELL OWNER: FIDELITY SAVINGS & LOAN RR#, ST. ADDRESS, BOX #: 100 E. English CITY, STATE, ZIP CODE: Wichita, Kansas		Board of Agriculture, Division of Water Resource Application Number:							
3 LOCATE WELL'S LOCATION WITH AN "X" IN SECTION BOX: 		4 DEPTH OF COMPLETED WELL 26 ft. ELEVATION: Depth(s) groundwater Encountered 1 ft. basement floor ft. 3 ft. WELL'S STATIC WATER LEVEL 14 FT. BELOW LAND SURFACE MEASURED ON 09/26/1992 Pump test data: Well water was _____ ft. after _____ hours pumping _____ gpm Est. Yield _____ gpm: Well water was _____ ft. after _____ hours pumping _____ gpm Bore Hole Diameter _____ in. to _____ ft., and _____ in. to _____ ft. WELL WATER TO BE USED AS: 5 Public water supply 8 Air conditioning 11 Injection well 1 Domestic 3 Feedlot 6 Oil field water supply 9 Dewatering 12 Other (Specify below) 2 Irrigation 4 Industrial 7 Lawn and garden only 10 Monitoring well Was a chemical/bacteriological sample submitted to Department? Yes _____ No X ; If yes, mo/day/yr sample was submitted _____ Water Well Disinfected? Yes X No _____							
5 TYPE OF CASING USED: 1 Steel 3 RMP (SR) 5 Wrought iron 8 Concrete tile CASING JOINTS: Glued Clamped 2 PVC 4 ABS 6 Asbestos-Cement 9 Other (Specify below) Welded Blank casing Diameter 1 1/4 in. to _____ ft., Dia _____ in. to _____ ft., Dia _____ in. to _____ ft. Casing height above land surface 60 in., weight _____ lbs. / ft. Wall thickness or gauge No. _____ TYPE OF SCREEN OR PERFORATION MATERIAL: 7 PVC 10 Asbestos-cement 1 Steel 3 Stainless Steel 5 Fiberglass 8 RMP (SR) 11 other (specify) _____ 2 Brass 4 Galvanized steel 6 Concrete tile 9 ABS 12 None used (open hole) _____ SCREEN OR PERFORATION OPENING ARE: 5 Gauzed wrapped 8 Saw cut 11 None (open hole) 1 Continuous slot 3 Mill slot 6 Wire wrapped 9 Drilled holes 2 Louvered shutter 4 Key punched 7 Torch cut 10 Other (specify) _____ SCREEN-PERFORATION INTERVALS: from _____ ft. to _____ ft., From _____ ft. to _____ ft. GRAVEL PACK INTERVALS: from _____ ft. to _____ ft., From _____ ft. to _____ ft.									
6 GROUT MATERIAL: 1 Neat cement 2 Cement grout 3 Bentonite 4 Other Grout Intervals: From 0 ft. to 10 ft., From _____ ft. to _____ ft., From _____ ft. to _____ ft. What is the nearest source of possible contamination: 10 Livestock pens 14 Abandon water well 1 Septic tank 4 Lateral lines 7 Pit privy 11 Fuel storage 15 Oil well/Gas well 2 Sewer lines 5 Cess pool 8 Sewage lagoon 12 Fertilizer storage 16 Other (specify below) _____ 3 Watertight sewer lines 6 Seepage pit 9 Feedyard 13 Insecticide storage Direction from well? West How many feet? 10 FROM TO LITHOLOGIC LOG FROM TO PLUGGING INTERVALS 0 10 cement grout 10 13.5 bentonite hole plug 13.5 26 chlorinated sand and gravel									
7 CONTRACTOR'S OR LANDOWNER'S CERTIFICATION: This water well was (1) constructed, (2) reconstructed, or (3) plugged under my jurisdiction and was completed on (mo/day/year) 09/26/1992 and this record is true to the best of my knowledge and belief. Kansas Water Well Contractor's License No. 236 This Water Well Record was completed on (mo/day/yr) 09/29/92 Under the business name of Harp Well & Pump Service, Inc. by (signature) <i>Jane Frederick</i>									