


1	LOCATION OF WATER WELL: Sedgwick	FRACTION NE 1/4 NW 1/4 SE 1/4	Section Number 18	Township Number T 27 S	Range Number R 1E E/W
---	--	---	-----------------------------	----------------------------------	---------------------------------

Distance and direction from nearest town or city street address of well if located within city?

942 N. Porter Wichita, Kansas

2	WATER WELL OWNER: ALFARO, Delbert RR#, ST. ADDRESS, BOX #: 942 N. Porter CITY, STATE, ZIP CODE: Wichita, Kansas 67203	Board of Agriculture, Division of Water Resource Application Number:
---	---	---

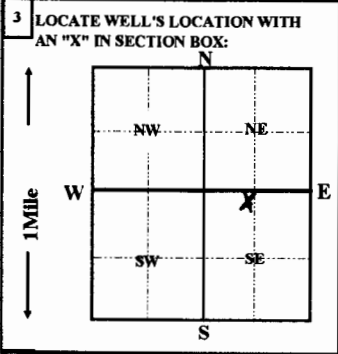

4	DEPTH OF COMPLETED ^{PLUGGED} WELL 40 ft. ELEVATION:
	Depth(s) groundwater Encountered 1 ft. 2 ft. 3 ft.
	WELL'S STATIC WATER LEVEL 16 FT. BELOW LAND SURFACE MEASURED ON 07/23/1992
	Pump test data: Well water was _____ ft. after _____ hours pumping _____ gpm
	Est. Yield _____ gpm: Well water was _____ ft. after _____ hours pumping _____ gpm
	Bore Hole Diameter unknown in. to _____ ft., and _____ in. to _____ ft.
	WELL WATER TO BE USED AS: 5 Public water supply 8 Air conditioning 11 Injection well
	1 Domestic 3 Feedlot 6 Oil field water supply 9 dewatering 12 Other (Specify below)
	2 Irrigation 4 Industrial 7 Lawn and garden only 10 Monitoring well
	Was a chemical/bacteriological sample submitted to Department? Yes _____ No X ; If yes, mo/day/yr sample was submitted _____
	Water Well Disinfected? Yes X No _____

5	TYPE OF CASING USED:	5 Wrought iron	8 Concrete tile	CASING JOINTS:	Glued	Clamped
	1 Steel	3 RMP (SR)	6 Asbestos-Cement	9 Other (Specify below)	Welded	
	2 PVC	4 ABS	7 Fiberglass		Threaded	X
	Blank casing Diameter 6 in. to _____ ft., Dia _____ in. to _____ ft.					
	Casing height ^{BELOW} above land surface 48 in., weight _____ lbs. / ft.				Wall thickness or gauge No.	
	TYPE OF SCREEN OR PERFORATION MATERIAL:	5 Fiberglass	8 RMP (SR)	10 Asbestos-cement		NA
	1 Steel	3 Stainless Steel	6 Concrete tile	9 ABS	11 other (specify)	
	2 Brass	4 Galvanized steel			12 None used (open hole)	
	SCREEN OR PERFORATION OPENING ARE:	5 Gauzed wrapped	8 Saw cut	11 None (open hole)		
	1 Continuous slot	3 Mill slot	6 Wire wrapped	9 Drilled holes		
	2 Louvered shutter	4 Key punched	7 Torch cut	10 Other (specify)	NA	
	SCREEN-PERFORATION INTERVALS: from _____ ft. to _____ ft.					
	GRAVEL PACK INTERVALS: from _____ ft. to _____ ft.					

6	GROUT MATERIAL: 1 Neat cement	2 Cement grout	3 Bentonite	4 Other
	Grout Intervals: From 30 ft. to 9 ft., From _____ ft. to _____ ft.			
	What is the nearest source of possible contamination:	7 Pit privy	10 Livestock pens	14 Abandon water well
	1 Septic tank	4 Lateral lines	11 Fuel storage	15 Oil well/Gas well
	2 Sewer lines	5 Cess pool	8 Sewage lagoon	12 Fertilizer storage
	3 Watertight sewer lines	6 Seepage pit	9 Feedyard	13 Insecticide storage
	Direction form well? East		How many feet? 20	

FROM	TO	LITHOLOGIC LOG	FROM	TO	PLUGGING INTERVALS
			0	3	compacted soil
			3	9	cement grout
			9	30	bentonite hole plug
			30	40	chlorinated sand and gravel

7	CONTRACTOR'S OR LANDOWNER'S CERTIFICATION: This water well was (1) constructed, (2) reconstructed, or (3) plugged under my jurisdiction and was completed on (mo/day/year) 07/23/1992 and this record is true to the best of my knowledge and belief. Kansas Water Well Contractor's License No. 236 This Water Well Record was completed on (mo/day/yr) 09/03/92 Under the business name of Harp Well & Pump Service, Inc by (signature) <i>Jane Frederick</i>
---	--