

Plugging Report


1 LOCATION OF WATER WELL:	Fraction	Section Number	Township Number	Range Number
County: <u>Salisbury</u>	<u>NW 1/4 NW 1/4 SE 1/4</u>	<u>19</u>	T <u>27</u> S	R <u>1</u> <u>EW</u>

Distance and direction from nearest town or city street address of well if located within city?

149 n Vine

2 WATER WELL OWNER:	Board of Agriculture, Division of Water Resources
RR#, St. Address, Box # : <u>149 n Vine</u>	Application Number: <u>none</u>
City, State, ZIP Code : <u>Wichita Kansas 67203</u>	

3 LOCATE WELL'S LOCATION WITH AN "X" IN SECTION BOX:	4 DEPTH OF COMPLETED WELL: <u>35</u> ft. ELEVATION: <u>1300</u>
--	---

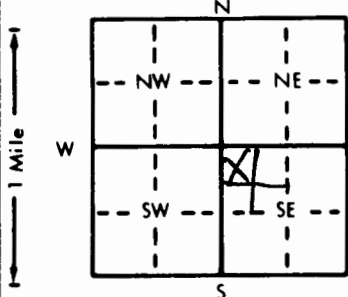






WELL WATER TO BE USED AS: 5 Public water supply 8 Air conditioning 11 Injection well

1 Domestic 3 Feedlot 6 Oil field water supply 9 Dewatering 12 Other (Specify below)

2 Irrigation 4 Industrial 7 Lawn and garden only 10 Monitoring well

Was a chemical/bacteriological sample submitted to Department? Yes X No X; If yes, mo/day/yr sample was submitted

Water Well Disinfected? Yes X No X

5 TYPE OF BLANK CASING USED:	5 Wrought iron	8 Concrete tile	CASING JOINTS: Glued <u>X</u> Clamped <u>X</u>
------------------------------	----------------	-----------------	--

1 Steel 3 RMP (SR) 6 Asbestos-Cement 9 Other (specify below) Welded X

2 PVC 4 ABS 7 Fiberglass Threaded X

Blank casing diameter 2 1/4 in. to 0 ft., Dia. 0 in. to 0 ft., Dia. 0 in. to 0 ft.

Casing height above land surface 0 in., weight 0 lbs./ft. Wall thickness or gauge No. 0

TYPE OF SCREEN OR PERFORATION MATERIAL: 7 PVC 10 Asbestos-cement

1 Steel 3 Stainless steel 5 Fiberglass 8 RMP (SR) 11 Other (specify)

2 Brass 4 Galvanized steel 6 Concrete tile 9 ABS 12 None used (open hole)

SCREEN OR PERFORATION OPENINGS ARE: 5 Gauzed wrapped 8 Saw cut 11 None (open hole)

1 Continuous slot 3 Mill slot 6 Wire wrapped 9 Drilled holes Sand Point

2 Louvered shutter 4 Key punched 7 Torch cut 10 Other (specify)





6 GROUT MATERIAL:	1 Neat cement	<u>2</u> Cement grout	3 Bentonite	4 Other
-------------------	---------------	-----------------------	-------------	---------

Grout Intervals: From 19 ft. to 0 ft., From 0 ft. to 0 ft., From 0 ft. to 0 ft.

What is the nearest source of possible contamination: 10 Livestock pens 14 Abandoned water well

1 Septic tank 4 Lateral lines 7 Pit privy 11 Fuel storage 15 Oil well/Gas well

2 Sewer lines 5 Cess pool 8 Sewage lagoon 12 Fertilizer storage 16 Other (specify below)

3 Watertight sewer lines 6 Seepage pit 9 Feedyard 13 Insecticide storage

Direction from well? West How many feet? 15

FROM	TO	LITHOLOGIC LOG	FROM	TO	PLUGGING INTERVALS
<u>35</u>	<u>19</u>	<u>Sand Fill</u>			
<u>19</u>	<u>0</u>	<u>Cement Grout</u>			