


1 LOCATION OF WATER WELL: County: Sedgwick Fraction: NE 1/4 NE 1/4 SE 1/4 Section Number: 20 Township Number: T 27 S Range Number: R 1 E

Distance and direction from nearest town or city street address of well if located within city?  
In Wichita

2 WATER WELL OWNER: State of Kansas  
 RR#, St. Address, Box #: 200 Williams Board of Agriculture, Division of Water Resources  
 City, State, ZIP Code: Wichita Ks. Application Number:

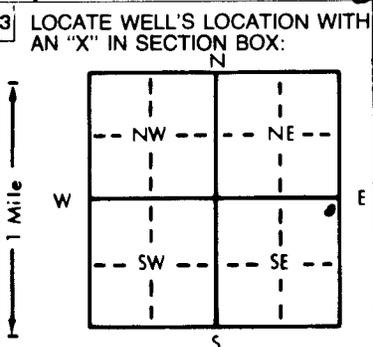

4 DEPTH OF COMPLETED WELL: 35' ft. ELEVATION:  
 Depth(s) Groundwater Encountered 1. 15' ft. 2. ft. 3. ft.  
 WELL'S STATIC WATER LEVEL: 14.93 ft. below land surface measured on mo/day/yr 5-25-93  
 Pump test data: Well water was ft. after hours pumping gpm  
 Est. Yield: 10' gpm; Well water was ft. after hours pumping gpm  
 Bore Hole Diameter: 7 1/2" in. to 35' ft. and in. to ft.  
 WELL WATER TO BE USED AS:  
 1 Domestic 2 Irrigation 3 Feedlot 4 Industrial 5 Public water supply 6 Oil field water supply 7 Lawn and garden only 8 Air conditioning 9 Dewatering 10 Monitoring well 11 Injection well 12 Other (Specify below)  
 Was a chemical/bacteriological sample submitted to Department? Yes No X; If yes, mo/day/yr sample was submitted Water Well Disinfected? Yes No

5 TYPE OF BLANK CASING USED:  
 1 Steel 2 PVC 3 RMP (SR) 4 ABS 5 Wrought iron 6 Asbestos-Cement 7 Fiberglass 8 Concrete tile 9 Other (specify below) CASING JOINTS: Glued Clamped Welded Threaded X  
 Blank casing diameter: 2.42 in. to 15' ft., Dia. in. to ft., Dia. in. to ft.  
 Casing height above land surface: Flush Ground in., weight lbs./ft. Wall thickness or gauge No. SDR-13  
 TYPE OF SCREEN OR PERFORATION MATERIAL:  
 1 Steel 2 Brass 3 Stainless steel 4 Galvanized steel 5 Fiberglass 6 Concrete tile 7 PVC 8 RMP (SR) 9 ABS 10 Asbestos-cement 11 Other (specify) 12 None used (open hole)  
 SCREEN OR PERFORATION OPENINGS ARE:  
 1 Continuous slot 2 Louvered shutter 3 Mill slot .010 4 Key punched 5 Gauzed wrapped 6 Wire wrapped 7 Torch cut 8 Saw cut 9 Drilled holes 10 Other (specify) 11 None (open hole)  
 SCREEN-PERFORATED INTERVALS: From 35 ft. to 15 ft., From ft. to ft., From ft. to ft.  
 GRAVEL PACK INTERVALS: From 35 ft. to 12' ft., From ft. to ft., From ft. to ft.

6 GROUT MATERIAL: 1 Neat cement 2 Cement grout 3 Bentonite 4 Other  
 Grout Intervals: From 12 ft. to 5 ft., From 5' ft. to 0 ft., From ft. to ft.  
 What is the nearest source of possible contamination:  
 1 Septic tank 2 Sewer lines 3 Watertight sewer lines 4 Lateral lines 5 Cess pool 6 Seepage pit 7 Pit privy 8 Sewage lagoon 9 Feedyard 10 Livestock pens 11 Fuel storage 12 Fertilizer storage 13 Insecticide storage 14 Abandoned water well 15 Oil well/Gas well 16 Other (specify below)  
 Direction from well? North How many feet? 10'  
Part of Gilbert/Healy Site

FROM	TO	LITHOLOGIC LOG	FROM	TO	PLUGGING INTERVALS
0	1.0	Asphalt/Concrete			
1.0	6.0	Fine-Med grained sand fill			
6.0	9.25	Brown silty sand/clay, mottled gray silt, iron oxide staining, clay plug at 7 1/2' & 8 1/2'			
9.25	33.0	Fine-coarse grained sand/bedding planes few gr. pebbles			
33.0	35.0	dk gray shale			

7 CONTRACTOR'S OR LANDOWNER'S CERTIFICATION: This water well was (1) constructed (2) reconstructed, or (3) plugged under my jurisdiction and was completed on (mo/day/year) 5-25-93 and this record is true to the best of my knowledge and belief. Kansas Water Well Contractor's License No. 539 This Water Well Record was completed on (mo/day/yr) 5-31-93 under the business name of QB Environmental Drilling by signature James Beebe

INSTRUCTIONS: Use typewriter or ball point pen. PLEASE PRESS FIRMLY and PRINT clearly. Please fill in blanks, underline or circle the correct answers. Send top three copies to Kansas Department of Health and Environment, Bureau of Water, Topeka, Kansas 66620-0001. Telephone: 913-296-5545. Send one to WATER WELL OWNER and retain one for your records.

OFFICE USE ONLY  
T  
R  
E  
M  
S  
E  
C.  
1/4  
1/4  
1/4