


1 LOCATION OF WATER WELL: County: Sedgwick	Fraction $\frac{1}{4}$ SE $\frac{1}{4}$ NW $\frac{1}{4}$	Section Number 21	Township Number T 27 S	Range Number R 1 E W
---	--	----------------------	---------------------------	-------------------------

Distance and direction from nearest town or city street address of well if located within city?
180' north of 1st St. in the east side of the alley located between St. Francis and Emporia

2 WATER WELL OWNER:	The Coleman Company	
RR#, St. Address, Box # :	250 N. St. Francis	Board of Agriculture, Division of Water Resources
City, State, ZIP Code :	Wichita, KS 67214	Application Number:

3	LOCATE WELL'S LOCATION WITH AN "X" IN SECTION BOX:	4	DEPTH OF COMPLETED WELL.....34.0.....ft. ELEVATION:1299.51.....
			Depth(s) Groundwater Encountered: 1 17.5 # 2 # 3 #

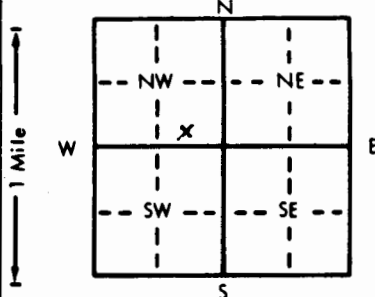

4 DEPTH OF COMPLETED WELL... 34.0... ft. ELEVATION: ... 1299.51...
 Depth(s) Groundwater Encountered 1. 17.5... ft. 2. ... ft. 3. ... ft.
 WELL'S STATIC WATER LEVEL ... 17.5... ft. below land surface measured on mo/day/yr ... 6/6/89...
 Pump test data: Well water was ... ft. after ... hours pumping ... gpm
 Est. Yield ... gpm: Well water was ... ft. after ... hours pumping ... gpm
 Bore Hole Diameter... 6.5... in. to 34.0... ft., and... in. to ... ft.
 WELL WATER TO BE USED AS: 5 Public water supply 8 Air conditioning 11 Injection well
 1 Domestic 3 Feedlot 6 Oil field water supply 9 Dewatering 12 Other (Specify below)
 2 Irrigation 4 Industrial 7 Lawn and garden only ☒ Monitoring well ... Industrial...
 Was a chemical/bacteriological sample submitted to Department? Yes.....No...X.....; If yes, mo/day/yr sample was sub
 mitted Water Well Disinfected? Yes No X

5	TYPE OF BLANK CASING USED:	5 Wrought iron	8 Concrete tile	CASING JOINTS: Glued	Clamped
	1 Steel	3 RMP (SR)	6 Asbestos-Cement	9 Other (specify below)	Welded
	X PVC	4 ABS	7 Fiberglass		Threaded X

Blank casing diameter . . . 2.0 . . . in. to . . . 15.0 . . . ft., Dia . . . 2.0 . . . in. to . . . 24.0 . . . ft., Dia . . . in. to . . . ft.
Casing height above land surface . . . Flush . . . in., weight . . . lbs./ft. Wall thickness or gauge No.

TYPE OF SCREEN OR PERFORATION MATERIAL:			<input checked="" type="checkbox"/> PVC	10 Asbestos-cement
1 Steel	3 Stainless steel	5 Fiberglass	8 RMP (SR)	11 Other (specify)
2 Brass	4 Galvanized steel	6 Concrete tile	9 ABS	12 None used (open hole)

SCREEN OR PERFORATION OPENINGS ARE:		5 Gauzed wrapped	8 Saw cut	11 None (open hole)
1 Continuous slot	<input checked="" type="checkbox"/> Mill slot	6 Wire wrapped	9 Drilled holes	
2 Louvered shutter	4 Key punched	7 Torch cut	10 Other (specify)	

SCREEN-PERFORATED INTERVALS: From 15.0 ft. to 25.0 ft., From . ft. to . ft.
From 24.0 ft. to 34.0 ft., From . ft. to . ft.

GRAVEL PACK INTERVALS:	From	12.0	ft. to	25.0	ft., From		ft. to		ft.
	From	17.0	ft. to	34.0	ft., From		ft. to		ft.

6 GROUT MATERIAL: 1 Neat cement 2 Cement grout 3 Bentonite 4 Other Volclay GROUT

Grout Intervals: From 1.0 ft. to 10.0 ft., From 1.0 ft. to 17.0 ft., From ft. to ft.

What is the nearest source of possible contamination:

1 Septic tank	4 Lateral lines	7 Pit privy	10 Livestock pens	14 Abandoned water well
2 Sewer lines	5 Cess pool	8 Sewage lagoon	11 Fuel storage	15 Oil well/Gas well
3 Watertight sewer lines	6 Seepage pit	9 Feedyard	12 Fertilizer storage	16 Other (specify below)
			13 Insecticide storage	Industry
Direction from well? East			How many feet? 100	

[illegible]

7 CONTRACTOR'S OR LANDOWNER'S CERTIFICATION: This water well was (1) constructed, (2) reconstructed, or (3) plugged under my jurisdiction and was completed on (mo/day/year) ... 6/6/89 ... and this record is true to the best of my knowledge and belief. Kansas Water Well Contractor's License No. ... 471 ... This Water Well Record was completed on (mo/day/yr) ... 6/9/89 ... under the business name of HWS Technologies Inc. by (signature) *[Signature]*