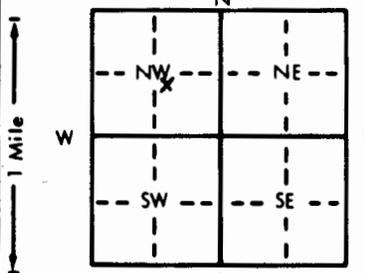


1 LOCATION OF WATER WELL: County: **Sedgwick** Fraction: **NW 1/4 SE 1/4 NW 1/4** Section Number: **21** Township Number: **T 27 S** Range Number: **R 1 EW**

Distance and direction from nearest town or city street address of well if located within city?
Southwest corner of 1st St. and Emporia

2 WATER WELL OWNER: **The Coleman Company**
 RR#, St. Address, Box # : **250 N. St. Francis** Board of Agriculture, Division of Water Resources
 City, State, ZIP Code : **Wichita, KS 67214** Application Number:

3 LOCATE WELL'S LOCATION WITH AN "X" IN SECTION BOX:

 4 DEPTH OF COMPLETED WELL: **34.0** ft. ELEVATION: **1299.8**
 Depth(s) Groundwater Encountered 1. **17.0** ft. 2. . ft. 3. . ft.
 WELL'S STATIC WATER LEVEL **16.98** ft. below land surface measured on mo/day/yr **6/9/89**
 Pump test data: Well water was . ft. after . hours pumping . gpm
 Est. Yield . gpm: Well water was . ft. after . hours pumping . gpm
 Bore Hole Diameter: **6.5** in. to **34.0** ft., and . in. to . ft.
 WELL WATER TO BE USED AS: 5 Public water supply 8 Air conditioning 11 Injection well
 1 Domestic 3 Feedlot 6 Oil field water supply 9 Dewatering 12 Other (Specify below)
 2 Irrigation 4 Industrial 7 Lawn and garden only ~~10~~ Monitoring well **Industrial**
 Was a chemical/bacteriological sample submitted to Department? Yes.....No **X**.....; If yes, mo/day/yr sample was submitted
 Water Well Disinfected? Yes No **X**

5 TYPE OF BLANK CASING USED: 5 Wrought iron 8 Concrete tile CASING JOINTS: Glued Clamped
 1 Steel 3 RMP (SR) 6 Asbestos-Cement 9 Other (specify below) Welded
~~X~~ PVC 4 ABS 7 Fiberglass Threaded. **X**
 Blank casing diameter . . . **2.0** . . . in. to . . **15.0** . . . ft., Dia . **2.0** . . . in. to . . **24.0** . . . ft., Dia in. to ft.
 Casing height above land surface. in., weight lbs./ft. Wall thickness or gauge No.
 TYPE OF SCREEN OR PERFORATION MATERIAL: ~~X~~ PVC 10 Asbestos-cement
 1 Steel 3 Stainless steel 5 Fiberglass 8 RMP (SR) 11 Other (specify)
 2 Brass 4 Galvanized steel 6 Concrete tile 9 ABS 12 None used (open hole)
 SCREEN OR PERFORATION OPENINGS ARE: 5 Gauzed wrapped 8 Saw cut 11 None (open hole)
 1 Continuous slot ~~X~~ Mill slot 6 Wire wrapped 9 Drilled holes
 2 Louvered shutter 4 Key punched 7 Torch cut 10 Other (specify)
 SCREEN-PERFORATED INTERVALS: From . . . **15.0** . . . ft. to . . . **25.0** . . . ft., From ft. to ft.
 From . . . **24.0** . . . ft. to . . . **34.0** . . . ft., From ft. to ft.
 GRAVEL PACK INTERVALS: From . . . **12.5** . . . ft. to . . . **25.0** . . . ft., From ft. to ft.
 From **22.0** . . . ft. to **34.0** . . . ft., From ft. to ft.

6 GROUT MATERIAL: 1 Neat cement 2 Cement grout 3 Bentonite 4 Other **Volclay Grout**
 Grout Intervals: From . . . **1.0** . . . ft. to . . **11.5** . . . ft., From . . **1.0** . . . ft. to . . **22.0** . . . ft., From ft. to ft.
 What is the nearest source of possible contamination:
 1 Septic tank 4 Lateral lines 7 Pit privy 10 Livestock pens 14 Abandoned water well
 2 Sewer lines 5 Cess pool 8 Sewage lagoon 11 Fuel storage 15 Oil well/Gas well
 3 Watertight sewer lines 6 Seepage pit 9 Feedyard 12 Fertilizer storage 16 Other (specify below)
 13 Insecticide storage **Industry**
 Direction from well? **Northeast** How many feet? **500**

FROM	TO	LITHOLOGIC LOG	FROM	TO	PLUGGING INTERVALS
0	5.0	Silty sand dark brown fill			
5.0	13.0	Silty clay mot. lt. grey & dk. rd brn.			
13.0	14.5	Poorly sorted fine sand light tan			
14.5	16.5	Well sorted fine sand light tan			
16.5	20.0	Well sorted coarse sand light tan			
20.0	25.0	Well sorted fine to coarse sand			
25.0	34.0	Well sorted coarse sand light tan			
34.0	35.0	Shale mot. lt. gray & dk. gray			

7 CONTRACTOR'S OR LANDOWNER'S CERTIFICATION: This water well was (1) constructed, (2) reconstructed, or (3) plugged under my jurisdiction and was completed on (mo/day/year) **6/9/89** and this record is true to the best of my knowledge and belief. Kansas Water Well Contractor's License No. **471** This Water Well Record was completed on (mo/day/yr) **6/13/89** under the business name of **HWS Technologies Inc.** by (signature) *[Signature]*

INSTRUCTIONS: Use typewriter or ball point pen. PLEASE PRESS FIRMLY and PRINT clearly. Please fill in blanks, underline or circle the correct answers. Send top three copies to Kansas Department of Health and Environment, Bureau of Water Protection, Topeka, Kansas 66620-7320. Telephone: 913-296-5514. Send one to WATER WELL OWNER and retain one for your records.

OFFICE USE ONLY